

WALTHALL
K 2001
6-26-78

MISSISSIPPI
BOARD OF WATER COMMISSIONERS
416 North State Street
Jackson, Mississippi 39201

WATER WELL DRILLERS LOG

June 20 1978 *Stofford well Ser.* *Walthall Co*
date well completed firm name county well located

LANDOWNER: *John D. Dyer*

Jefferson Miss
(mailing address)

WELL LOCATION:
sec. 3 T 1 N R 12 E
9.2 miles S/W of Dexter
(distance) (direction) (nearest town)

WELL PURPOSE: Home
(home, irrigation, municipal, industrial)

WELL COMPLETION DATA:

- (1) diameter (inches) 4"
- (2) total depth (feet) 144 ft.
- (3) static water level (feet) _____ below
top of ground. above
- (4) casing plastic 134
(material) (depth)
- 4"
(size) If telescope see back.
- (5) screen 10 ft. 134
(length) (depth to top)
- 4" plastic
(size) (material)
- (6) pump 1/2 hp
(HP) (yield gpm)
- Electric
(type power)
- (7) electric log (yes or no) _____
- (organization running log) _____
- (8) how well bottom plugged BWW


description of formations encountered	from	to
@ top Soil	0	2
Sandy clay	2	30
Sand	30	45
clay	45	80
sand	80	120
sand & FE NE gravel	120	144

DRILLERS REMARKS:
[Signature]

RECEIVED
AUG 21 1978
MISS. HD. OF WATER COMM.

If well telescopes please sketch and show depths.

70
GROUND LEVEL

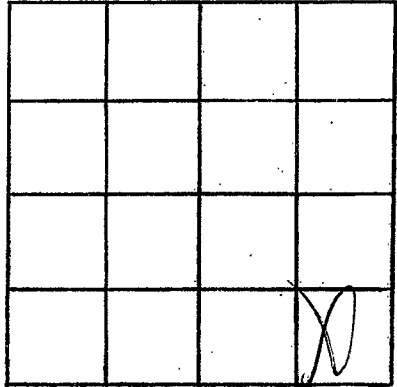

SECTION _____

Please indicate well location X.

ADDITIONAL INFORMATION

If more than one screen,
show locations of each on sketch.