

WALTHALL
K2002
8/78

MISSISSIPPI
BOARD OF WATER COMMISSIONERS
416 North State Street
Jackson, Mississippi 39201

WATER WELL DRILLERS LOG

date well completed 19 8/78 firm name Stofford Well Serv. county well located Walthall Co.

LANDOWNER: E. P. Owens

description of formations encountered	from	to
	<u>top soil</u>	<u>0</u>
<u>clay</u>	<u>2</u>	<u>85</u>
<u>sand</u>	<u>45</u>	<u>100</u>
<u>sand & gravel</u>	<u>100</u>	<u>123</u>


Jefferson Miss
(mailing address)

WELL LOCATION:
sec. 3 T. 1 N. R. 12 E.
10 miles S/E of Deater
(distance) (direction) (nearest town)

WELL PURPOSE: Home
(home, irrigation, municipal, industrial)


- WELL COMPLETION DATA:
- (1) diameter (inches) 4"
 - (2) total depth (feet) 123 ft.
 - (3) static water level (feet) _____ below above top of ground.
 - (4) casing plastic, 113,
(material) (depth)
4" if telescope see back.
(size)
 - (5) screen 10, 113
(length) (depth to top)
4", plastic
(size) (material)
 - (6) pump 1 (HP) _____ (yield gpm)
Elect
(type power)
 - (7) electric log _____ (yes or no)
(organization running log)
 - (8) how well bottom plugged BWV

DRILLERS REMARKS:
[Signature]

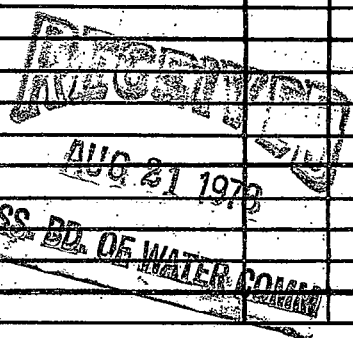

If well telescopes please sketch and show depths.

GROUND LEVEL

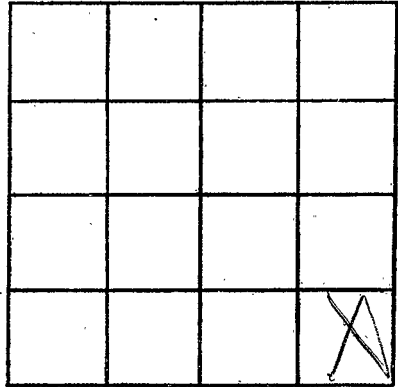

SECTION _____

Please indicate well location X.

ADDITIONAL INFORMATION

If more than one screen,
show locations of each on sketch.