

WALTHALL
 # 2014
 6-12-78

MISSISSIPPI
 BOARD OF WATER COMMISSIONERS
 416 North State Street
 Jackson, Mississippi 39201

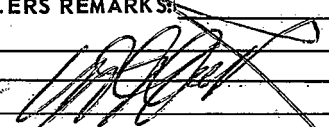
WATER WELL DRILLERS LOG

June 12 1978 date well completed
 J. Stafford Miller Co. firm name
 Walthall Co. county well located

LANDOWNER: <u>Rene Bell</u>	description of formations encountered	from	to
	top soil	0	2
<u>Lylestown Miss.</u> (mailing address)	clay	2	30
WELL LOCATION: sec. <u>3</u> T. <u>1</u> N. R. <u>12</u> E	sandy clay	30	45
<u>10</u> miles <u>S/E</u> of <u>Porter</u>	sand	45	95
(distance) (direction) (nearest town)	sand & gravel	95	120

WELL PURPOSE: Home
 (home, irrigation, municipal, industrial)

- WELL COMPLETION DATA:
- (1) diameter (inches) 4"
 - (2) total depth (feet) 120 ft
 - (3) static water level (feet) _____ below above top of ground.
 - (4) casing plastic, 110,
(material) (depth)
4" if telescope see back.
(size)
 - (5) screen 10 ft, 110
(length) (depth to top)
4", plastic
(size) (material)
 - (6) pump 1/4 (HP) (yield gpm)
Elect
(type power)
 - (7) electric log (yes or no) _____
(organization running log) _____
 - (8) how well bottom plugged RWU

DRILLERS REMARKS:


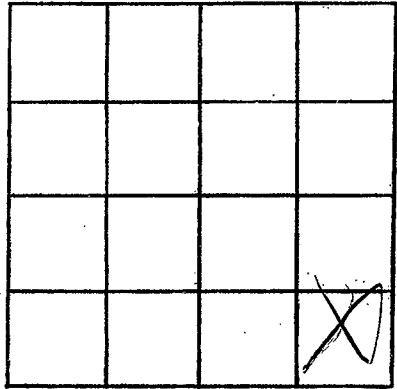
RECEIVED

AUG 21 1978

MISS. BD. OF WATER COMM.

If well telescopes please sketch and show depths.

GROUND LEVEL



SECTION _____

Please indicate well location X.

ADDITIONAL INFORMATION

If more than one screen,
show locations of each on sketch.