

WALTHALL

K 2015

01-24-79

MISSISSIPPI BOARD OF WATER COMMISSIONERS 416 North State Street Jackson, Mississippi 39201

WATER WELL DRILLERS LOG

Jan 24 1979 Reems Walker Walthall date well completed firm name county well located

LANDOWNER: Jerry Popwell Rt. 1 Syleston (mailing address)

Table with 3 columns: description of formations encountered, from, to. Entries include Red Clay, Red sand, sand & gravel, lobbly ground, lobbly & gravel, sand & clay gravel.

WELL LOCATION: sec. 16 T-1 N R-12 E 10 miles S-SE of Syleston (distance) (direction) (nearest town)

WELL PURPOSE: home (home, irrigation, municipal, industrial)

- WELL COMPLETION DATA: (1) diameter (inches) 4" (2) total depth (feet) 136 (3) static water level (feet) 105 below top of ground (4) casing plastic bottom (material) (depth) (5) screen 5' length 131 depth to top (6) pump 1/2 HP 10 yield gpm (7) electric log no (yes or no)

(8) how well bottom plugged: wooden plug

DRILLERS REMARKS:


Miss. Board of Water Comm.

APR 26 1979

RECEIVED

If well telescopes please sketch and show depths.

GROUND LEVEL

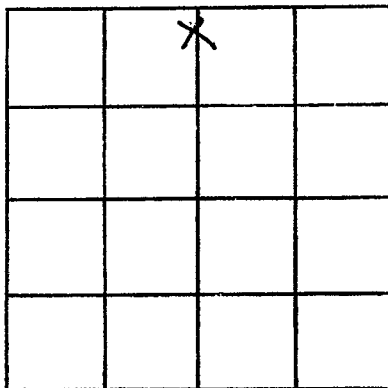

SECTION 16

Please indicate well location X.

ADDITIONAL INFORMATION

If more than one screen, show locations of each on sketch.