

Walthall

MISSISSIPPI BOARD OF WATER COMMISSIONERS
416 North State Street
Jackson, Mississippi 39201

R 2057
5-12-80

WATER WELL DRILLERS LOG

5-12
date well completed

1980 Fluid well by
firm name

Walthall
county well located

LANDOWNER:

Leth Stogner

P.B. Tyler
(mailing address)

description of formations encountered

from to

Red Clay 0 20
Red Sand 20 110
Coarse Sandstone 110 120

WELL LOCATION:

sec. 21 T. 1 N R. 12 E
S W
3 miles S of Dexter
(distance) (direction) (nearest town)

WELL PURPOSE: Home
(home, irrigation, municipal, industrial)

WELL COMPLETION DATA:

- (1) diameter (inches) 4
- (2) total depth (feet) 120
- (3) static water level (feet) 85 below above top of ground.
- (4) casing PVC, 112, (material) (depth)
4 (size) If telescope see back.
- (5) screen 8, 112 (length) (depth to top)
4 (size) PVC (material)
- (6) pump 1/2 (HP) 10 (yield gpm)
Ele (type power)
- (7) electric log (yes or no)
(organization running log)
- (8) how well bottom plugged Seal block

DRILLERS REMARKS:


DEPT. OF NATURAL RESOURCES
BUREAU OF LAND & WATER RESOURCES

JUN 20 1980

RECEIVED

If well telescopes please sketch and show depths.

GROUND LEVEL

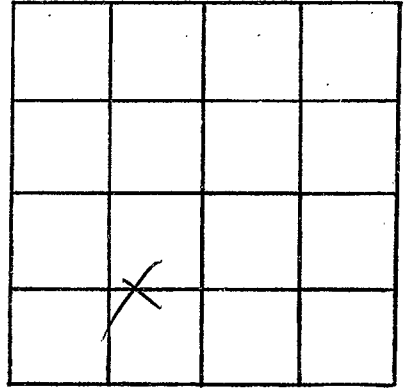

SECTION 21

Please indicate well location X.

ADDITIONAL INFORMATION

If more than one screen,
show locations of each on sketch.