

WALTHALL
K 208
7-29-81

MISSISSIPPI
BOARD OF WATER COMMISSIONERS
416 North State Street
Jackson, Mississippi 39201

WATER WELL DRILLERS LOG

July 29 1980 *Reussmiller* *Walthall*
date well completed firm name county well located

LANDOWNER:
Clarence Clezy
Rt 2 - Tylertown
(mailing address)

WELL LOCATION:
sec. *18* T. *1* N. R. *12* E
3 miles *W1SW* of *Dexter*
(distance) (direction) (nearest town)

WELL PURPOSE: *home*
(home, irrigation, municipal, industrial)


WELL COMPLETION DATA:
(1) diameter (inches) *4"*
(2) total depth (feet) *129'*
(3) static water level (feet) *87* below top of ground.
(4) casing *plastic*, *bottom*
(material) (depth)
_____ if telescope see back.
(size)
(5) screen *5'*, *124'*
(length) (depth to top)
4", *plastic*
(size) (material)
(6) pump *axatus*
(HP) (yield gpm)
elct
(type power)
(7) electric log *no*
(yes or no)

(organization running log)

(8) how well bottom plugged
backwash valve

DRILLERS REMARKS:
/

description of formations encountered	from	to
<i>clay</i>	<i>0</i>	<i>27</i>
<i>sand & gravel</i>	<i>27</i>	<i>60</i>
<i>chalk</i>	<i>60</i>	<i>68</i>
<i>mixed sand & gravel</i>	<i>68</i>	<i>70</i>
<i>red chalk</i>	<i>70</i>	<i>120</i>
<i>course sand</i>	<i>120</i>	<i>129</i>

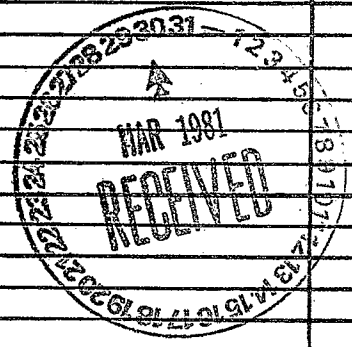

If well telescopes please sketch and show depths.

GROUND LEVEL

		X	

SECTION 18

Please indicate well location X.

ADDITIONAL INFORMATION

If more than one screen,
show locations of each on sketch.