


WALTHALL  
K 209  
7-17-81

MISSISSIPPI  
BOARD OF WATER COMMISSIONERS  
416 North State Street  
Jackson, Mississippi 39201

WATER WELL DRILLERS LOG


7-17 date well completed 1981 firm name *F. J. Gulliver* county well located *Walthall*

LANDOWNER:	description of formations encountered	from	to
<i>Jimmy Lourey</i> <i>RR 1, Walthall</i> (mailing address)	<i>Red Clay</i> <i>Red Sand &amp; gravel</i> <i>Crumb Sand &amp; gravel</i>	<i>0</i> <i>20</i> <i>105</i>	<i>20</i> <i>105</i> <i>123</i>
WELL LOCATION: sec. <i>5</i> T <i>1</i> N R <i>12</i> E S W <i>2</i> miles <i>W</i> of <i>Drift</i> (distance) (direction) (nearest town)			
WELL PURPOSE: <i>Home</i> (home, irrigation, municipal, industrial)			
WELL COMPLETION DATA: (1) diameter (inches) <i>4</i> (2) total depth (feet) <i>123</i> (3) static water level (feet) <i>60</i> below above top of ground. (4) casing <i>102</i> , <i>115</i> , (material) (depth) <i>4</i> If telescope see back. (size) (5) screen <i>8</i> , <i>115</i> (length) (depth to top) <i>4</i> , <i>102</i> (size) (material) (6) pump <i>1/2</i> , <i>10</i> (HP) (yield gpm) <i>elm</i> (type power) (7) electric log <i>yes</i> (yes or no) (organization running log) (8) how well bottom plugged <i>Seal</i>			
DRILLERS REMARKS:			

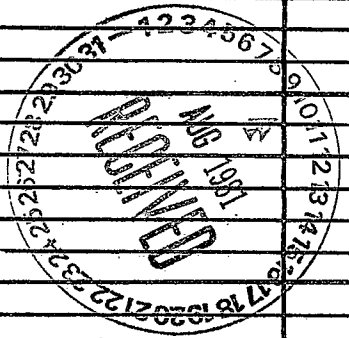

If well telescopes please sketch and show depths.

GROUND LEVEL

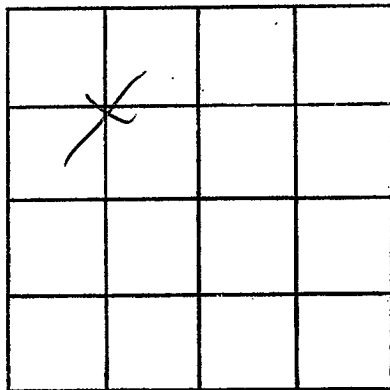

SECTION 5

Please indicate well location X.

ADDITIONAL INFORMATION

If more than one screen, show locations of each on sketch.