

Walthall
 R 2000
 6-12-81

MISSISSIPPI
 BOARD OF WATER COMMISSIONERS
 416 North State Street
 Jackson, Mississippi 39201

3

WATER WELL DRILLERS LOG

6-72 1981 Stogard Well Drilling Walthall
 date well completed firm name county well located


LANDOWNER: Elgin Thomas	description of formations encountered	from	to
Jylertown (mailing address)	top soil	0	2
	sandy clay	2	30
	clay	30	80
	fine sand	80	120
	coarse sand	120	150

WELL LOCATION:
 sec. 3 T. 1 N. R. 12 E. S. 5 W.
 5 miles SSE of Decker (distance) (direction) (nearest town)

WELL PURPOSE: Home (home, irrigation, municipal, industrial)


- WELL COMPLETION DATA:
- (1) diameter (inches) 4"
 - (2) total depth (feet) 150
 - (3) static water level (feet) 120 below top of ground
 - (4) casing (material) (depth) 150
 4" (size) If telescope see back.
 - (5) screen (length) (depth to top) 120 ft., 120 ft.
 4" (size) (material) plastic
 - (6) pump (HP) (yield gpm) 1/2 HP
 (type power) elect
 - (7) electric log (yes or no)
 - (organization running log)
 - (8) how well bottom plugged BAW

DRILLERS REMARKS:
 [Signature]

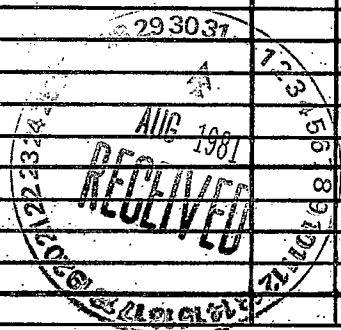

If well telescopes please sketch and show depths.

GROUND LEVEL

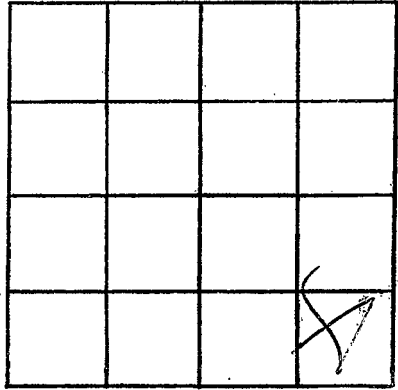

SECTION _____

Please indicate well location X.

ADDITIONAL INFORMATION

If more than one screen,
show locations of each on sketch.