

Wells
 Walthall
 K 2021

MISSISSIPPI
 BOARD OF WATER COMMISSIONERS
 416 North State Street
 Jackson, Mississippi 39201

WATER WELL DRILLERS LOG

PLUMBING & WELL SERVICE, INC.

1/22/82 date well completed 19 firm name Walthall county well located

LANDOWNER:	description of formations encountered	from	to
Nathan Simms	Top Soil	0	1'
1217	Clay gravel	1	30
Tylertown, MS	Chalk	30	60
(mailing address)	Sand & Pea gravel	60	170

WELL LOCATION:
 sec. 26 T 1 N R 12 E
 S W
 10 miles S of Dexter
 (distance) (direction) (nearest town)

WELL PURPOSE: Home
 (home, irrigation, municipal, industrial)

- WELL COMPLETION DATA:
- (1) diameter (inches) 4"
 - (2) total depth (feet) 170'
 - (3) static water level (feet) 90' below top of ground.
 - (4) casing PVC, 150' (material) (depth)
 - N/A if telescope see back. (size)
 - (5) screen 20', 150' (length) (depth to top)
 - 4" PVC (size) (material)
 - (6) pump 1/2, 10 (HP) (yield gpm)
 - Elec (type power)
 - (7) electric log No (yes or no)
 - N/A (organization running log)
 - (8) how well bottom plugged 130W

DRILLERS REMARKS:


DEPT. OF NATURAL RESOURCES
 BUREAU OF LAND & WATER RESOURCES

JUN - 9 1982

RECEIVED

If well telescopes please sketch and show depths.

GROUND LEVEL

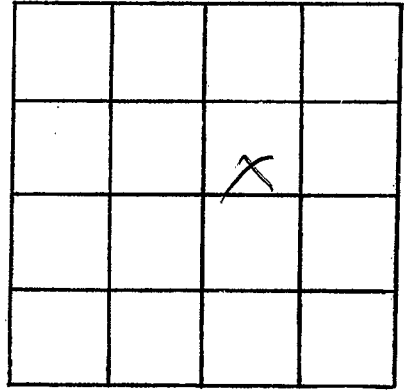

SECTION 26

Please indicate well location X.

ADDITIONAL INFORMATION

If more than one screen,
show locations of each on sketch.