

Complete well with pump

Walthall
Kearney

MISSISSIPPI
BOARD OF WATER COMMISSIONERS
416 North State Street
Jackson, Mississippi 39201

WATER WELL DRILLERS LOG

Water Well
Walthall, Miss
Searcy
Ralph Cather Water Well

April 27
date well completed

19 83 -
Searcy
Ralph Cather

LANDOWNER:
Copper River Marine
P.O. Box 1211
(mailing address)

description of formations encountered
Red Clay and sand
Bottom of well
sand and gravel

WELL LOCATION:
sec. 17 T. 1 N. R. 12 E.
18-20 S. W.
10 miles
(distance) of (direction) (nearest town)
Jasper Louisiana

WELL PURPOSE: home use
(home, irrigation, municipal, industrial)

- WELL COMPLETION DATA:
- (1) diameter (inches) 4 in
 - (2) total depth (feet) 95
 - (3) static water level (feet) 65 below top of ground.
 - (4) casing PVC, 95 (material) (depth)
 - (size) If telescope see back.
 - (5) screen 10 (length) 65 (depth to top)
 - (size) (material)
 - (6) pump 1/2 (HP) 600 gal/hr (yield/gpm)
220 Volt (type power)
 - (7) electric log (yes or no)

DEPT. OF NATURAL RESOURCES
BUREAU OF LAND & WATER RESOURCES

MAY 5 - 1983


(8) how well bottom plugged
Best
Wash water

DRILLERS REMARKS:
Good
well plenty
of water

RECEIVED

If well telescopes please
sketch and show depths.

GROUND LEVEL

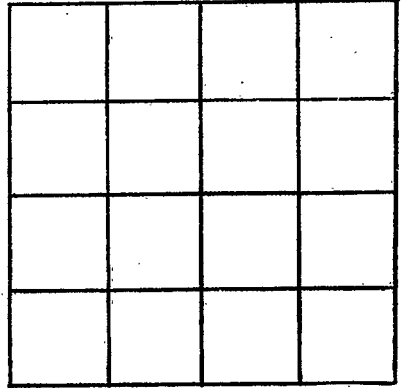

SECTION _____

Please indicate well location X.

ADDITIONAL INFORMATION

If more than one screen,
show locations of each on sketch.