

BOARD OF WATER COMMISSIONERS

416 North State Street

Jackson, Mississippi 39201

WATER WELL DRILLERS LOG

Walshall  
Kearse

9-15-84

R. Cottrell's Drilling Walshall

date well completed

firm name

county well located

LANDOWNER:

Richard Lee, Rt. 1

description of formations encountered

from

to

red clay  
sandy gravel  
water bearing sand

0 70'  
70 300

Box 150, Sandyhook Miss

(mailing address)

WELL LOCATION:

2 1/2 mi. E. of R. 1  
DeWitt, Miss. on  
Lee Rd.

(distance) (direction) of (nearest town)

WELL PURPOSE:

home (home, irrigation, municipal, industrial)

WELL COMPLETION DATA:

- (1) diameter (inches) 4 in.
- (2) total depth (feet) 100
- (3) static water level (feet) 80 below top of ground.
- (4) casing 4 in. (material) (depth)
- (size) if telescope see back.
- (5) screen 10' (length) (depth to top)  
4" plastic (size) (material)
- (6) pump 220 (HP) (yield gpm)  
1/2 (type power)
- (7) electric log (yes or no)

(organization running log)

(8) how well bottom plugged

L.W. Valve

DRILLERS REMARKS:

Well Good


DEPT. OF NATURAL RESOURCES  
BUREAU OF LAND & WATER RESOURCES

OCT 29 1984

RECEIVED

If well telescopes please  
sketch and show depths.

GROUND LEVEL

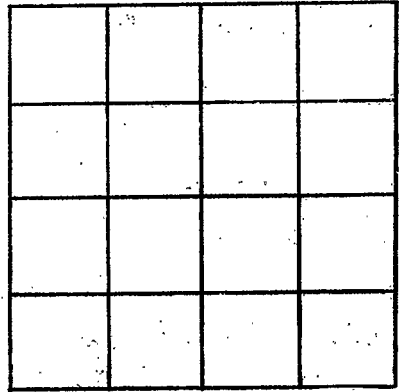

SECTION \_\_\_\_\_

Please indicate well location X.

ADDITIONAL INFORMATION

If more than one screen,  
show locations of each on sketch.