

MISSISSIPPI DEPARTMENT OF NATURAL RESOURCES

Bureau of Land and Water Resources

Southport Mall

P.O. Box 10631

Jackson, Mississippi 39209

WATER WELL DRILLERS LOG

WALTBALL
K
2025

11/20 1986 Tom Griffith Water Wells Walthall
 date well completed firm name county well located

LANDOWNER: <u>Cooper Forber</u>	description of formations encountered	from	to
<u>Rt. 7 Box 146 B</u>			
<u>Tylertown, MS 39667</u> (mailing address)	<u>clay</u> <u>gravel</u>	<u>1</u>	<u>10</u> <u>150</u>

WELL LOCATION:
 sec. 21 T. 1 N. R. 12 E.
3 miles S of Dexter
 (distance) (direction) (nearest town)

WELL PURPOSE: Home
 (home, irrigation, municipal, industrial)

- WELL COMPLETION DATA:
- (1) diameter (inches) 4"
 - (2) total depth (feet) 150'
 - (3) static water level (feet) 80' below above top of ground.
 - (4) casing PVC, 130'
 (material) (depth)
NA if telescope see back.
 (size)
 - (5) screen 20', 130'
 (length) (depth to top)
4", PVC
 (size) (material)
 - (6) pump 3/4, 10
 (HP) (yield gpm)
Elv.
 (type power)
 - (7) electric log no
 (yes or no)
7/1/86
 (organization running log)
 - (8) how well bottom plugged 1300V

RECEIVED


MAR 17 1986

Department of Natural Resources
 Bureau of Land and Water Resources

DRILLERS REMARKS: _____

If well telescopes please sketch and show depths.

GROUND LEVEL

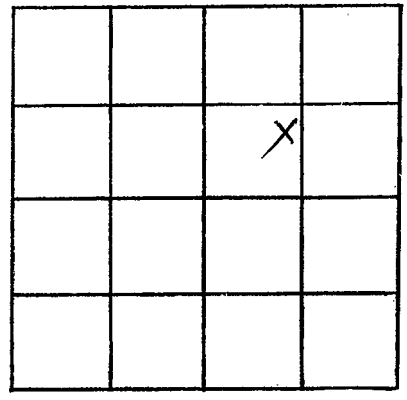

SECTION 21

Please indicate well location X.

ADDITIONAL INFORMATION

A series of horizontal lines for writing additional information, starting below the 'ADDITIONAL INFORMATION' header and extending to the bottom of the page.

If more than one screen, show locations of each on sketch.