

MISSISSIPPI DEPARTMENT OF NATURAL RESOURCES

Bureau of Land and Water Resources

Southport Mall

P.O. Box 10631

Jackson, Mississippi 39209

WATER WELL DRILLERS LOG

WALTHALL
K. 2006

3-24

date well completed

19

Fitzgerald Well Serv

firm name

Walthall

county well located

LANDOWNER: Joe Martin
P.O. Lytleton, Mo.
(mailing address)

description of formations encountered	from	to
<u>Red clay</u>	<u>0</u>	<u>20</u>
<u>Red sand</u>	<u>20</u>	<u>80</u>
<u>Coarse sand & gravel</u>	<u>80</u>	<u>95</u>

WELL LOCATION:
sec. 4 T. 1 N. R. 12 E. S. W
14 miles (distance) Dexter (direction) of (nearest town)

WELL PURPOSE: Home
(home, irrigation, municipal, industrial)

WELL COMPLETION DATA:

(1) diameter (inches) 4

(2) total depth (feet) 95

(3) static water level (feet) 50 below above top of ground.

(4) casing PVC, 85 (material), (depth)
4 (size) if telescope see back.


(5) screen 10, 85 (length), (depth to top)
4 (size), PVC (material)

(6) pump 3/4, 15 (HP), (yield gpm)
Elmer (type power)

(7) electric log yes (yes or no)
(organization running log)

(8) how well bottom plugged Sealed


DRILLERS REMARKS:

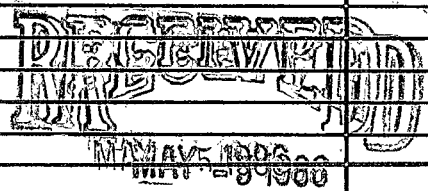

De
Department of Natural Resources
Bureau of Land & Water Resources

If well telescopes please
sketch and show depths.

GROUND LEVEL

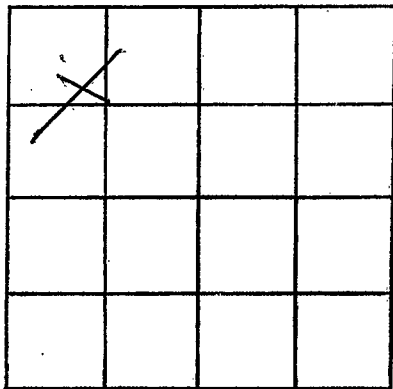

SECTION 4

Please indicate well location X.

ADDITIONAL INFORMATION

Lined area for additional information.

If more than one screen,
show locations of each on sketch.