

MISSISSIPPI DEPARTMENT OF NATURAL RESOURCES

Bureau of Land and Water Resources

Southport Mall

P.O. Box 10631

Jackson, Mississippi 39209

WATER WELL DRILLERS LOG

11

WALTER
KOON

4-2-


19 86 Fitzgerald area near New Walsh
firm name county well located

date well completed

firm name

county well located

LANDOWNER:	description of formations encountered	from	to
<u>Magnolia Federal</u> <u>P.O. Box Hattiesburg, ms.</u> (mailing address)	<u>Red Clay</u> <u>Red Sand</u> <u>Coarse sand & gravel</u>	<u>0</u> <u>20</u> <u>90</u>	<u>20</u> <u>90</u> <u>118</u>
WELL LOCATION:			
sec. <u>18</u> T <u>1</u> N R <u>12</u> E S W <u>4</u> miles <u>S</u> of <u>ORAL</u> (distance) (direction) (nearest town)			
WELL PURPOSE: <u>Home</u> (home, irrigation, municipal, industrial)			
WELL COMPLETION DATA:			
(1) diameter (inches) <u>4</u>			
(2) total depth (feet) <u>118</u>			
(3) static water level (feet) <u>20</u> below above top of ground.			
(4) casing <u>PVC, 108,</u> (material) (depth) <u>4</u> if telescope see back. (size)			
(5) screen <u>PVC, 108</u> (length) (depth to top) <u>4</u> (size) <u>PVC</u> (material)			
(6) pump <u>1/2</u> <u>10</u> (HP) (yield gpm) <u>elec</u> (type power)			
(7) electric log <u>no</u> (yes or no) (organization running log)			
(8) how well bottom plugged <u>Sand fill</u>			

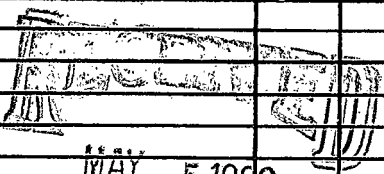


MAY - 5 1986

DRILLERS REMARKS:

Department of Natural Resources
Bureau of Land & Water

If well telescopes please sketch and show depths.

GROUND LEVEL

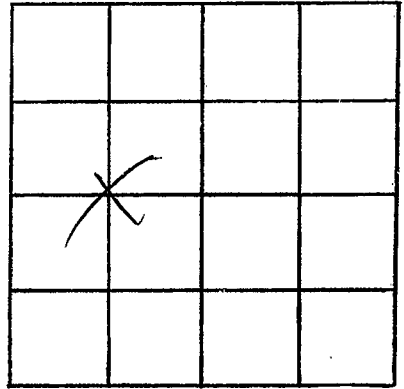

SECTION 18

Please indicate well location X.

ADDITIONAL INFORMATION

If more than one screen,
show locations of each on sketch.