

WALTHALL  
 K 1008

MISSISSIPPI  
 BOARD OF WATER COMMISSIONERS  
 416 North State Street  
 Jackson, Mississippi 39201


WATER WELL DRILLERS LOG

5/11/86 19 Red Martin Water Well Walthall  
 date well completed firm name county well located

LANDOWNER:	description of formations encountered	from	to
Lavelle Branch Etux Rt 7 Box 184 Tylertown, Ms 39667 (mailing address)	Top clay Sand Gravel	0 20 65	20 66 69
WELL LOCATION: sec. 27 T-1 N RL2 E S W 14 miles SE Tylertown (distance) (direction) (nearest town)	Thin to several Feet of gravel 2' below top	69	90
WELL PURPOSE: Home (home, irrigation, municipal, industrial)			
WELL COMPLETION DATA:			
(1) diameter (inches) 4"			
(2) total depth (feet) 90'			
(3) static water level (feet) 70 below top of ground.			
(4) casing 160-pvc, 80' (material) (depth) (size) if telescope see back.			
(5) screen 10' 80' (length) (depth to top)			
(6) pump 1/4 8 (HP) (yield gpm) 220 volt (type power)			
(7) electric log (yes or no) <input checked="" type="checkbox"/>			
(organization running log)			
(8) how well bottom plugged 2" sand & gravel Back wash valve			
DRILLERS REMARKS:			

If well telescopes please sketch and show depths.

GROUND LEVEL

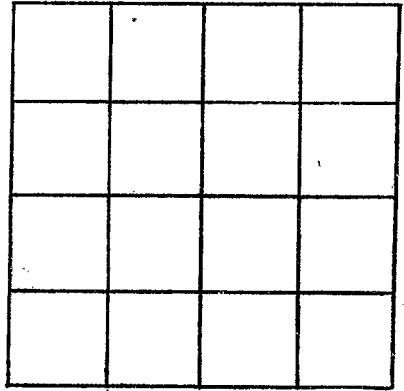

SECTION \_\_\_\_\_

Please indicate well location X.

ADDITIONAL INFORMATION

If more than one screen,  
show locations of each on sketch.