

MISSISSIPPI DEPARTMENT OF NATURAL RESOURCES

Bureau of Land and Water Resources

Southport Mall

P.O. Box 10631

Jackson, Mississippi 39209

WATER WELL DRILLERS LOG

WAGMAU
K 2009

7-30
date well completed

1986 *F. H. ...*
firm name

... ..
county well located

LANDOWNER:
Jerry Pigott
RR - Dexter, Miss.
(mailing address)

description of formations encountered	from	to
<i>Red clay</i>	<i>0</i>	<i>20</i>
<i>Red sand</i>	<i>20</i>	<i>140</i>
<i>Course sand & gravel</i>	<i>140</i>	<i>155</i>

WELL LOCATION:
sec. 28 T 1 N R 12 E
S W
3 miles S of Dexter
(distance) (direction) (nearest town)

WELL PURPOSE: GOLF COURSE
(home, irrigation, municipal, industrial)

WELL COMPLETION DATA:

(1) diameter (inches) 4

(2) total depth (feet) 155

(3) static water level (feet) 60 below top of ground.

(4) casing PVC, 145 (material), (depth),
4 (size) if telescope see back.

(5) screen 10 (length), 145 (depth to top),
4 (size), PVC (material)

(6) pump 1 (HP), 20 (yield gpm)
Electric (type power)

(7) electric log No (yes or no)
... (organization running log)

(8) how well bottom plugged ...


RECEIVED
AUG 13 1986

Department of Natural Resources
Bureau of Land & Water Resources

DRILLERS REMARKS:

If well telescopes please sketch and show depths.

GROUND LEVEL

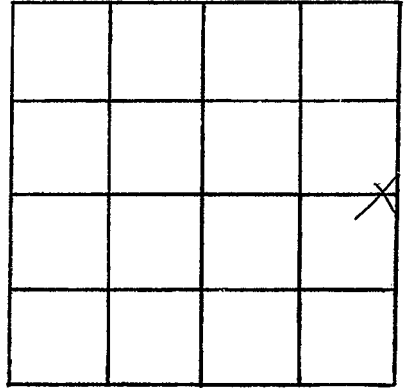

SECTION 28

Please indicate well location X.

ADDITIONAL INFORMATION

If more than one screen,
show locations of each on sketch.