

WALTHALL
K 0030

MISSISSIPPI DEPARTMENT OF NATURAL RESOURCES
Bureau of Land and Water Resources
Southport Mall
P.O. Box 10631
Jackson, Mississippi 39209
WATER WELL DRILLERS LOG

8-19 1986 Federal well Sew Walthall
date well completed firm name county well located


LANDOWNER:
Richard Delrie
R.R. Lytleman Ms.
(mailing address)

WELL LOCATION:
sec. 5 T 1 N R 12 E
S W
1 1/2 miles NW of Dexter
(distance) (direction) (nearest town)

WELL PURPOSE: Home
(home, irrigation, municipal, industrial)

- WELL COMPLETION DATA:
- (1) diameter (inches) 4
- (2) total depth (feet) 108
- (3) static water level (feet) 40 below
top of ground.
- (4) casing PVC, 98
(material) (depth)
4
(size) if telescope see back.
- (5) screen 10, 98
(length) (depth to top)
4 PVC
(size) (material)
- (6) pump 1/2, 10
(HP) (yield gpm)
Electric
(type power)
- (7) electric log No
(yes or no)
Electric
(organization running log)
- (8) how well bottom plugged Sand blk

description of formations encountered	from to	
	ft	ft
<u>Red clay</u>	<u>0</u>	<u>20</u>
<u>white chert</u>	<u>20</u>	<u>80</u>
<u>Green Sand & gravel</u>	<u>80</u>	<u>108</u>

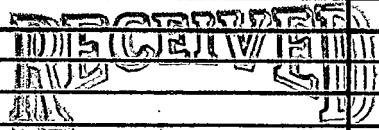


Department of Natural Resources
Bureau of Land and Water Resources

DRILLERS REMARKS:

If well telescopes please sketch and show depths.

GROUND LEVEL

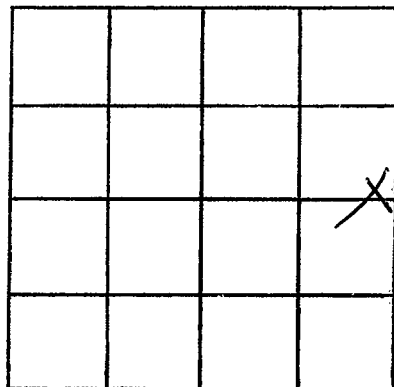

SECTION 5

Please indicate well location X.

ADDITIONAL INFORMATION

If more than one screen,
show locations of each on sketch.