

WALTHAM CO.

MISSISSIPPI DEPARTMENT OF NATURAL RESOURCES

Bureau of Land and Water Resources

COUNTY WELL LOCATED
 WALKER
 WELL NUMBER: **K** CODED
2033
 DATE WELL COMPLETED: **4-17-89**

PERMIT NUMBER: **0-428**
 NAME OF DRILLING FIRM: **WALKER-DRILLING**

P.O. Box 10631
 Jackson, Mississippi 39209
 WATER WELL DRILLERS LOG

NAME & MAILING ADDRESS OF LANDOWNER
POLK DARY
KENITH POLK
DEXTURE MS.
 WELL LOCATION: SEC **7** TOWNSHIP **1** RANGE **12** ^N _S ^E _W
 DISTANCE **5** Miles **NORTH** of **DEXTURE**
 OTHER LANDMARK
 WELL PURPOSE: Home, Irrigation, Municipal, Industrial, Fish Pond, etc.

PUMP DATA
 PUMP TYPE (Circle One): Submersible, Turbine, Jet, Flowing Well, Other (Describe) _____
 POWER TYPE (Circle One): Electric, Tractor, Diesel, Gasoline, Butane, Other (Describe) _____
 Pump Capacity (GPM) **18** No. of Stages **8** Setting Depth **120 FT.**
 PUMP TEST
 Well yielded _____ GPM with a drawdown of _____ ft. after _____ hours of pumping

WELL DATA
 Well Depth **130** Casing Diameter (In.) **4"** Casing Length (Ft.) **120**
 Type of Casing **PVC** Hole Depth **131** Depth to Static Water Level **60'**
 TYPE OF COMPLETION: (Circle One or More): Gravel Packed, Underreamed, Telescoped, Natural Development, Open Hole, Other
AIR
 Top of Lap Pipe or Reduction in Casing
 FEET IF TELESCOPED OR MORE THAN ONE SCREEN: USE BACK PAGE

LOG DATA
 TYPE OF LOG RUN (Circle One): No Log Run, Electric, Gamma Ray, Density, Sonic, Neutron, Other (Describe) _____
 Name of Organization Running Log

SCREEN DATA
 Diameter - Inches **4"** Length - Feet **10"** Slot Size - Inches **#12**
 Screen Type **JWRAP** Depth to Bottom - Feet **130**

GEOLOGIC DATA (Office Use Only)

Surface Elev.	Geologic Unit	Unit Thickness	Depth to Top
Subs. SWL	Date	Analysis	Aquifer Test


Driller's Remarks

DESCRIPTION OF FORMATIONS ENCOUNTERED	FROM	TO	FORMATIONS (continued)	FROM	TO
RED CLAY	0	15	<div style="border: 2px solid black; padding: 5px; display: inline-block;"> RECEIVED MAY 11 1989 Department of Natural Resources Bureau of Land & Water Resources </div>		
SANDY RED	15	25			
SAND	25	35			
SAND & ROCKS	35	118			
SAND	118	130			

IF MORE SPACE IS NEEDED, USE BACK

If well telescopes please sketch and show depths.

GROUND LEVEL

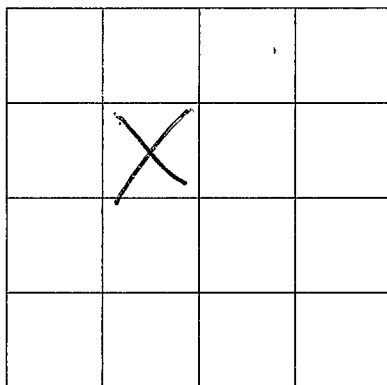

	X		

SECTION _____

Please indicate well location X.

ADDITIONAL INFORMATION

If more than one screen,
show location of each on sketch.