

MISSISSIPPI DEPARTMENT OF ENVIRONMENTAL QUALITY

Office of Land and Water Resources

P. O. Box 10631
Jackson, MS 39289-0631

WATER WELL DRILLERS LOG

COUNTY WHERE LOCATED <i>Walthall</i>	
WELL NUMBER <i>R</i>	CODED
DATE WELL COMPLETED <i>2045</i> <i>Oct 5-92</i>	

PERMIT NUMBER
NAME OF DRILLING FIRM <i>FitzGERARD Well Serv</i>

NAME & MAILING ADDRESS OF LANDOWNER <i>Ronald Smith</i> <i>RR. 1, Glendon, ms.</i>		
WELL LOCATION: SEC <i>9</i> TOWNSHIP <i>1</i> RANGE <i>12</i>	N S	E W
DISTANCE <i>2</i> Miles DIRECTION <i>SW</i> NEAREST TOWN <i>Decker</i>		
OTHER LANDMARK		
WELL PURPOSE: Home, Irrigation, Municipal, Industrial, Fish Pond, etc. <i>Home</i>		

PUMP DATA		
PUMP TYPE (Circle One): <input checked="" type="checkbox"/> Submersible, Turbine, Jet, Flowing Well, Other (Describe) _____		
POWER TYPE (Circle One): <input checked="" type="checkbox"/> Electric, Tractor, Diesel, Gasoline, Butane, Other (Describe) _____ H/P <i>1/2</i>		
Pump Capacity (GPM) <i>10</i>	No. of Stages <i>8</i>	Setting Depth _____ FT.
PUMP TEST		
Well yielded <i>90</i> GPM with a drawdown of <i>2</i> ft. after <i>2</i> hours of pumping		

WELL DATA		
Well Depth <i>142</i>	Casing Diameter (In.) <i>4</i>	Casing Length (Ft.) <i>4</i>
Type of Casing <i>POC</i>	Hole Depth <i>142</i>	Depth to Static Water Level <i>63</i>
TYPE OF COMPLETION: (Circle One or More): <input checked="" type="checkbox"/> Gravel Packed, <input type="checkbox"/> Underreamed, <input type="checkbox"/> Telescoped, <input type="checkbox"/> Natural Development, <input type="checkbox"/> Open Hole, <input type="checkbox"/> Other (Describe) _____		

LOG DATA	
TYPE OF LOG RUN (Circle One): Electric, Gamma Ray, Density, Sonic, Neutron, Other (Describe) _____	
Name of Organization Running Log <i>No Log Run</i>	

WELL GROUTED TO A DEPTH OF <i>10</i> FEET Type Grout (circle one): <input checked="" type="checkbox"/> Cement, <input type="checkbox"/> Bentonite, or Mix
--

GEOLOGIC DATA (Office Use Only)			
Surface Elev.	Geologic Unit	Unit Thickness	Depth to Top
Subs. SWL	Date	Analysis	Aquifer Test

SCREEN DATA		
Diameter - Inches <i>4</i>	Length - Feet <i>10</i>	Slot Size - Inches <i>1014</i>
Screen Type <i>POC</i>	Depth to Bottom - Feet <i>142</i>	


Driller's Remarks

DESCRIPTION OF FORMATIONS ENCOUNTERED	FROM	TO	FORMATIONS (Continued)	FROM	TO
<i>Red Clay</i>	<i>0</i>	<i>20</i>	RECEIVED DEC 07 1992 Dept. of Environmental Quality Bureau of Land & Water Resources		
<i>Red Sand</i>	<i>20</i>	<i>125</i>			
<i>COURSE SAND & GRAVEL</i>	<i>125</i>	<i>142</i>			

IF MORE SPACE IS NEEDED, USE BACK

If well telescopes please sketch and show depths.

GROUND LEVEL

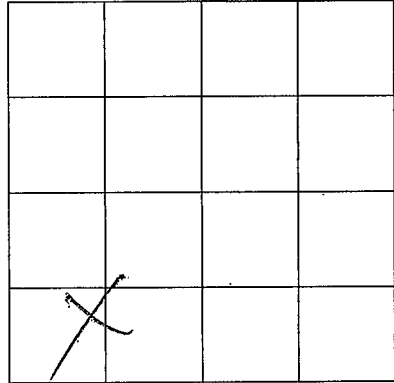

SECTION 9
Please indicate well location X.

ADDITIONAL INFORMATION

If more than one screen,
show location of each on sketch.