

MISSISSIPPI DEPARTMENT OF ENVIRONMENTAL QUALITY

Office of Land and Water Resources

P. O. Box 10631
Jackson, MS 39289-0631

WATER WELL DRILLERS LOG

COUNTY WELL LOCATED <u>Walthall</u>	
WELL NUMBER <u>R</u>	CODED
DATE WELL COMPLETED <u>2009 7-13-95</u>	

PERMIT NUMBER
NAME OF DRILLING FIRM <u>Fitzgerald Well Service</u>

NAME & MAILING ADDRESS OF LANDOWNER <u>Drew LeBlanc</u>		
<u>RR Tyler town</u>		
WELL LOCATION: SEC <u>3</u> TOWNSHIP <u>1</u> RANGE <u>12</u>	N S	E W
DISTANCE <u>10</u> Miles	DIRECTION <u>SE</u>	NEAREST TOWN <u>Tyler town</u>
OTHER LANDMARK		
WELL PURPOSE: <input checked="" type="radio"/> Home Irrigation, Municipal, Industrial, Fish Pond, etc. <u>Home</u>		

PUMP DATA		
PUMP TYPE (Circle One): <input checked="" type="radio"/> Submersible, Turbine, Jet, Flowing Well, Other (Describe)		
POWER TYPE (Circle One): Electric, Tractor, Diesel, Gasoline, Butane, Other (Describe) <u>H/P 112</u>		
Pump Capacity (GPM) <u>20</u>	No. of Stages <u>10</u>	Setting Depth <u>107'</u> FT.
PUMP TEST		
Well yielded <u>50</u> GPM with a drawdown of <u>1</u> ft. after <u>1</u> hours of pumping		

WELL DATA		
Well Depth <u>152'</u>	Casing Diameter (In.) <u>4"</u>	Casing Length (Ft.) <u>132'</u>
Type of Casing <u>PVC</u>	Hole Depth <u>152'</u>	Depth to Static Water Level <u>57'</u>

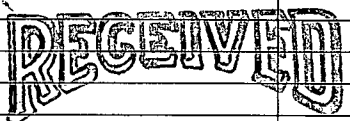
LOG DATA	
TYPE OF LOG RUN (Circle One): Electric, Gamma Ray, Density, Sonic, Neutron, Other (Describe) <input checked="" type="radio"/> No Log Run	
Name of Organization Running Log	

TYPE OF COMPLETION: (Circle One or More): <input checked="" type="radio"/> Gravel Packed, Underreamed, Telescoped, Natural Development, Open Hole, Other		
WELL GROUTED TO A DEPTH OF <u>10</u> FEET Type Grout (circle one): Cement, Bentonite <input checked="" type="radio"/> or Mix		

GEOLOGIC DATA (Office Use Only)			
Surface Elev.	Geologic Unit	Unit Thickness	Depth to Top
Subs. SWL	Date	Analysis	Aquifer Test

SCREEN DATA		
Diameter - Inches <u>4"</u>	Length - Feet <u>20"</u>	Slot Size - Inches <u>010/012</u>
Screen Type <u>PVC</u>	Depth to Bottom - Feet <u>152'</u>	

Driller's Remarks

DESCRIPTION OF FORMATIONS ENCOUNTERED	FROM	TO	FORMATIONS (Continued)	FROM	TO
<u>Topsoil</u>	<u>0</u>	<u>5</u>	 JUL 19 1995 Dept. of Environmental Quality Office of Land & Water Resources		
<u>Red clay</u>	<u>5</u>	<u>40</u>			
<u>Sand & gravel</u>	<u>40</u>	<u>70</u>			
<u>White clay</u>	<u>70</u>	<u>100</u>			
<u>Fine sand</u>	<u>100</u>	<u>130</u>			
<u>Coarse sand & gravel</u>	<u>130</u>	<u>152'</u>			

IF MORE SPACE IS NEEDED, USE BACK

If well telescopes please sketch and show depths.

GROUND LEVEL

SECTION _____

Please indicate well location X.

ADDITIONAL INFORMATION

If more than one screen,
show location of each on sketch.