

MISSISSIPPI DEPARTMENT OF ENVIRONMENTAL QUALITY

Office of Land and Water Resources

P. O. Box 10631  
Jackson, MS 39289-0631  
WATER WELL DRILLERS LOG

COUNTY WELL LOCATED <b>Walthall</b>	
WELL NUMBER <b>R 2068</b>	CODED
DATE WELL COMPLETED <b>8/19/97</b>	

PERMIT NUMBER <b>0-508</b>
NAME OF DRILLING FIRM <b>Jordan Well Serv.</b>

NAME & MAILING ADDRESS OF LANDOWNER <b>Larry Jacobs</b>			
<b>Copper Ford Rd</b>			
<b>Tylertown, Miss</b>			
WELL LOCATION:	SEC	TOWNSHIP	RANGE
	<b>3</b>	<b>1 N</b>	<b>12 E</b>
			<b>W</b>
DISTANCE	DIRECTION	NEAREST TOWN	
<b>6</b> Miles	<b>S/E</b>	<b>of Tylertown</b>	
OTHER LANDMARK			
WELL PURPOSE <input checked="" type="radio"/> Home Irrigation, Municipal, Industrial, Fish Pond, etc.			

PUMP DATA			
PUMP TYPE (Circle One): <input checked="" type="radio"/> Submersible, Turbine, Jet, Flowing Well, Other (Describe) _____			
POWER TYPE (Circle One): <input checked="" type="radio"/> Electric, Tractor, Diesel, Gasoline, Butane, Other (Describe) _____ H/P _____			
Pump Capacity (GPM)	No. of Stages	Setting Depth	FT.
<b>10</b>	<b>8</b>	<b>80</b>	
PUMP TEST			
Well yielded _____ GPM with a drawdown of _____ ft. after _____ hours of pumping			

WELL DATA		
Well Depth <b>85</b>	Casing Diameter (In.) <b>4</b>	Casing Length (Ft.) <b>75</b>
Type of Casing <b>PVC</b>	Hole Depth <b>85</b>	Depth to Static Water Level <b>70</b>
TYPE OF COMPLETION: (Circle One or More): Gravel Packed, Underreamed, Telescoped, Natural Development, Open Hole, Other (Describe) _____		
WELL GROUTED TO A DEPTH OF <b>10 FEET</b> Type Grout (circle one): Cement, Bentonite, or Mix <input checked="" type="radio"/>		

LOG DATA			
TYPE OF LOG RUN (Circle One): No Log Run, Electric, Gamma Ray, Density, Sonic, Neutron, Other (Describe) _____			
Name of Organization Running Log			

SCREEN DATA		
Diameter - Inches <b>4</b>	Length - Feet <b>10</b>	Slot Size - Inches <b>.010</b>
Screen Type <b>PVC</b>	Depth to Bottom - Feet <b>75</b>	


GEOLOGIC DATA (Office Use Only)			
Surface Elev.	Geologic Unit	Unit Thickness	Depth to Top
Subs. SWL	Date	Analysis	Aquifer Test
Driller's Remarks			
Top of Lap Pipe or Reduction in Casing			
FEET	IF TELESCOPED OR MORE THAN ONE SCREEN: USE BACK PAGE		

DESCRIPTION OF FORMATIONS ENCOUNTERED	FROM	TO
<b>Top Soil</b>	<b>0</b>	<b>1</b>
<b>Sandy Clay</b>	<b>1-65</b>	
<b>Sand</b>	<b>65-85</b>	

FORMATIONS (Continued)	FROM	TO
<b>RECEIVED</b>		
<b>AUG 25 1997</b>		
Dept. of Environmental Quality Office of Land & Water Resources		

If well telescopes please sketch and show depths.

GROUND LEVEL

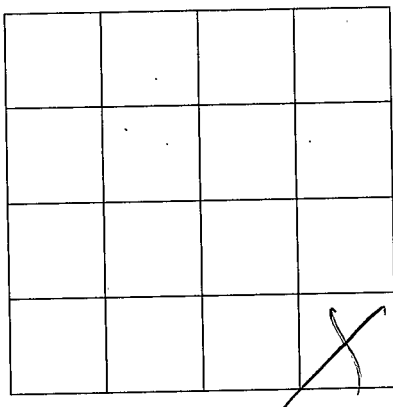

SECTION 3

Please indicate well location X.

ADDITIONAL INFORMATION

If more than one screen,  
show location of each on sketch.