

MISSISSIPPI DEPARTMENT OF ENVIRONMENTAL QUALITY

Office of Land and Water Resources

P. O. Box 10631
Jackson, MS 39289-0631
WATER WELL DRILLERS LOG

COUNTY WELL LOCATED Waltham	
WELL NUMBER R 7971	CODED
DATE WELL COMPLETED 11/26/92	

PERMIT NUMBER 0-508
NAME OF DRILLING FIRM Jordan Well Ser.

NAME & MAILING ADDRESS OF LANDOWNER Donald R. Brown			
WELL LOCATION: SEC 3 TOWNSHIP 1 N RANGE 12 E			
DISTANCE 7 Miles ESE DIRECTION of tyler town NEAREST TOWN			
OTHER LANDMARK			
WELL PURPOSE: <input checked="" type="checkbox"/> Home Irrigation, <input type="checkbox"/> Municipal, <input type="checkbox"/> Industrial, <input type="checkbox"/> Fish Pond, etc.			

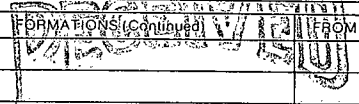
PUMP DATA			
PUMP TYPE (Circle One): <input checked="" type="radio"/> Submersible, <input type="radio"/> Turbine, <input type="radio"/> Jet, <input type="radio"/> Flowing Well, Other (Describe) _____			
POWER TYPE (Circle One): <input checked="" type="radio"/> Electric, <input type="radio"/> Tractor, <input type="radio"/> Diesel, <input type="radio"/> Gasoline, <input type="radio"/> Butane, Other (Describe) _____ H/P 1/2			
Pump Capacity (GPM) 10	No. of Stages 8	Setting Depth 105 FT.	
PUMP TEST			
Well yielded _____ GPM with a drawdown of _____ ft. after _____ hours of pumping			

WELL DATA		
Well Depth 112	Casing Diameter (In.) 4	Casing Length (Ft.) 102
Type of Casing PDC	Hole Depth 112	Depth to Static Water Level 80
TYPE OF COMPLETION: (Circle One or More): <input type="checkbox"/> Gravel Packed, <input type="checkbox"/> Underreamed, <input type="checkbox"/> Telescoped, <input type="checkbox"/> Natural Development, <input type="checkbox"/> Open Hole, <input type="checkbox"/> Other (Describe) _____		
WELL GROUTED TO A DEPTH OF 10 FEET Type Grout (circle one): Cement, Bentonite, <input checked="" type="checkbox"/> Mix		

LOG DATA	
TYPE OF LOG RUN (Circle One): <input type="radio"/> No Log Run, <input type="radio"/> Electric, <input type="radio"/> Gamma Ray, <input type="radio"/> Density, <input type="radio"/> Sonic, <input type="radio"/> Neutron, Other (Describe) _____	
Name of Organization Running Log	

SCREEN DATA		
Diameter - Inches 4	Length - Feet 70	Slot Size - Inches 10/10
Screen Type PVC	Depth to Bottom - Feet 102	

GEOLOGIC DATA (Office Use Only)			
Surface Elev.	Geologic Unit	Unit Thickness	Depth to Top
Subs. SWL	Date	Analysis	Aquifer Test
Driller's Remarks			
Top of Lap Pipe or Reduction in Casing			
FEET		IF TELESCOPED OR MORE THAN ONE SCREEN-USE BACK PAGE	

DESCRIPTION OF FORMATIONS ENCOUNTERED	FROM	TO	FORMATIONS (continued)	FROM	TO
Top Soil	0	1	 DEC 04 1997 Dept. of Environmental Quality Office of Land & Water Resources		
SANDY CLAY	1	40			
Gravel	40	65			
SAND & Gravel	65	112			

IF MORE SPACE IS NEEDED, USE BACK

If well telescopes please sketch and show depths.

GROUND LEVEL

			X

SECTION 3

Please indicate well location X.

ADDITIONAL INFORMATION

If more than one screen,
show location of each on sketch.