

MISSISSIPPI DEPARTMENT OF ENVIRONMENTAL QUALITY

Office of Land and Water Resources

P. O. Box 10631
Jackson, MS 39289-0631
WATER WELL DRILLERS LOG

COUNTY WELL LOCATED Walthall	
WELL NUMBER K-2094	CODED
DATE WELL COMPLETED 9-12-01	

PERMIT NUMBER 0-621
NAME OF DRILLING FIRM Daniel Boone
Tylerstown, MS

NAME & MAILING ADDRESS OF LANDOWNER Cindy Gibson 67 Lowery Loop Tylerstown
Latitude: Longitude:
WELL LOCATION: SEC 5 TOWNSHIP 1 N RANGE 12 E
DISTANCE 8 Miles DIRECTION SE of NEAREST TOWN Tylerstown
OTHER LANDMARK
WELL PURPOSE: <input checked="" type="radio"/> Home, Irrigation, Municipal, Industrial, Fish Pond, etc.

PUMP DATA

PUMP TYPE (Circle One):
 Submersible, Turbine, Jet, Flowing Well,
 Other (Describe) _____

POWER TYPE (Circle One):
 Electric, Tractor, Diesel, Gasoline, Butane,
 Other (Describe) _____ H/P _____

DESCRIPTION OF FORMATIONS ENCOUNTERED	FROM	TO
Clay	0	20
Sand	20	90
Large Gravel	90	105
Sand Pea Gravel Mix	105	140

WELL DATA

Well Depth 140	Casing Diameter (In.) 4"	Casing Length (Ft.) 120
Type of Casing PVC	Hole Depth 140	Depth to Static Water Level 90'
TYPE OF COMPLETION: (Circle One or More): <input checked="" type="radio"/> Gravel Packed, <input type="radio"/> Underreamed, <input type="radio"/> Telescoped, <input type="radio"/> Natural Development, <input type="radio"/> Open Hole, <input type="radio"/> Other (Describe) _____		

WELL GROUTED TO A DEPTH OF 15 FEET
 Type Grout (circle one): Cement, Bentonite, or Mix

SCREEN DATA

Diameter - Inches 4	Length - Feet 20'	Slot Size - Inches .010
Screen Type PVC Sch 40	Depth to Bottom - Feet 0	

RECEIVED
MAY 20 2002
BY: OLWR

Top of Lap Pipe or Reduction in Casing
FEET IF TELESCOPED OR MORE THAN ONE SCREEN: USE BACK PAGE


I certify that the well was drilled, constructed and completed in accordance with all applicable Requirements of the Mississippi Department of Environmental Quality and/or the Mississippi Department of Health regulations and state laws.

Daniel Boone 0-621
Signature of Licensed Driller and License No.

5-11-02
Date

If well telescopes please sketch and show depths.

GROUND LEVEL

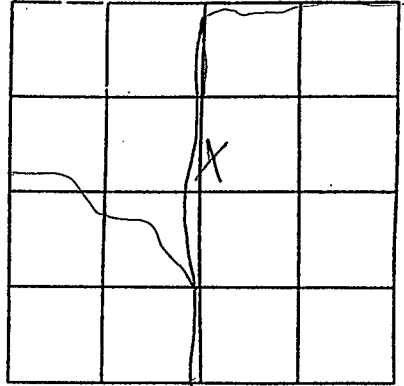

SECTION 5

Please indicate well location X.

Pump Capacity (GPM) <u>12</u>	No. of Stages	Setting Depth <u>115</u> FT.
----------------------------------	---------------	---------------------------------

PUMP TEST

Well yielded 18 GPM with
a drawdown of 15 ft.
after 24 hours of pumping

LOG DATA

TYPE OF LOG RUN (Circle One): No Log Run,
Electric, Gamma Ray, Density, Sonic, Neutron,
Other (Describe)

Name of Organization Running Log

GEOLOGIC DATA (Office Use Only)

Surface Elev.	Geologic Unit	Unit Thickness	Depth to Top
Subs. SWL	Date	Analysis	Aquifer Test

Driller's Remarks

If more than one screen,
show location of each on sketch.