

Walshall  
L 1  
7-66

**CODED**

MISSISSIPPI  
BOARD OF WATER COMMISSIONERS  
416 North State Street  
Jackson, Mississippi 39201

WATER WELL DRILLERS LOG

7-1 1966 Fitzgerald Water Well Sew Walshall  
date well completed firm name county well located

LANDOWNER: Hillman Thomas  
Sandy Hook, Miss  
(mailing address)

description of formations encountered	from	to
Sandy	0	80
Sand & gravel	80	100
Heavy gravel	100	120
Chalk white	120	140
Coarse Sand & gravel	140	180


WELL LOCATION:  
sec. 14 T. 1 N. R. 13 E.  
6 miles W of Sandy Hook  
(distance) (direction) (nearest town)

WELL PURPOSE: home  
(home, irrigation, municipal, industrial)

- WELL COMPLETION DATA:
- (1) diameter (inches) 4
  - (2) total depth (feet) 129
  - (3) static water level (feet) 110 below top of ground.
  - (4) casing plastic 171 (material), (depth)  
4 (size) if telescope see back.
  - (5) screen 8 171 (length), (depth to top)  
4" plastic (size), (material)
  - (6) pump 1/2 Sub 9 (HP), (yield gpm)  
elec (type power)
  - (7) electric log 170 (yes or no)  
(organization running log)
  - (8) how well bottom plugged Wood peg


**CODED**

DRILLERS REMARKS:

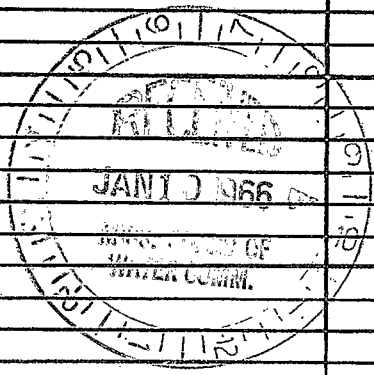

If well telescopes please sketch and show depths.

GROUND LEVEL

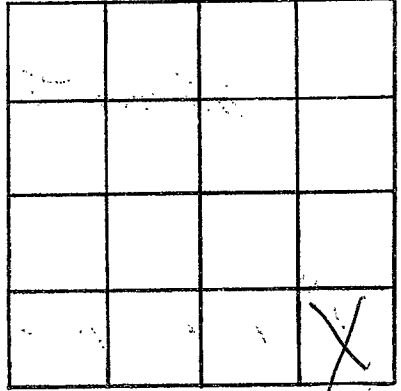

SECTION *ref*

Please indicate well location X.

ADDITIONAL INFORMATION

If more than one screen, show locations of each on sketch.