

Walthall
L 2
4-67

COPIED

MISSISSIPPI
 BOARD OF WATER COMMISSIONERS
 416 North State Street
 Jackson, Mississippi 39201

WATER WELL DRILLERS LOG

4/1 1967 Andis Peeling Co. Walthall
 date well completed firm name county well located

LANDOWNER: R. S. NEARNEY
Pt. 1 Box 79c
Sandy Hook Miss.
 (mailing address)

WELL LOCATION:
 sec 7 T 1 N R 13 E
4 1/2 miles S. E of Dexter
 (distance) (direction) (nearest town)


WELL PURPOSE: Home
 (home, irrigation, municipal, industrial)

WELL COMPLETION DATA:

- (1) diameter (inches) 4"
- (2) total depth (feet) 140'
- (3) static water level (feet) 70' below above top of ground.
- (4) casing P.V.C. 134'
 (material) (depth)
4" if telescope see back.
 (size)
- (5) screen 6' 134'
 (length) (depth to top)
4" P.V.C.
 (size) (material)
- (6) pump 1 12 gal.
 (HP) (yield gpm)
220
 (type power)
- (7) electric log no
 (yes or no)
 (organization running log)
- (8) how well bottom plugged Back
Wash Valve

description of formations encountered	from	to
<u>Red Clay</u>	<u>0'</u>	<u>40'</u>
<u>GRAVEL</u>	<u>40'</u>	<u>60'</u>
<u>Chalk</u>	<u>60'</u>	<u>80'</u>
<u>Sand</u>	<u>80'</u>	<u>120'</u>
<u>Coarse Sand / Red gravel</u>	<u>120'</u>	<u>140'</u>

COPIED

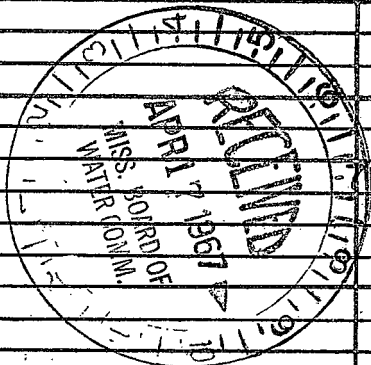

DRILLERS REMARKS:

