

Waltheil
L 3
6-67

ADDED

MISSISSIPPI
BOARD OF WATER COMMISSIONERS
416 North State Street
Jackson, Mississippi 39201

WATER WELL DRILLERS LOG

6/30 1967 Ande's Drilling Co. Waltheil
date well completed firm name county well located

LANDOWNER: A.W. McPain
Rt. 2 Sandy Hook
Miss.
(mailing address)

description of formations encountered	from	to
Red Clay	0'	40'
Sand	40'	90'
Chalk	90'	140'
Sand	140'	170'
Coarse Sand (fragments)	170'	180'


WELL LOCATION:
sec. 21 T. 1 N. R. 13 E.
2 miles S.E. of Imperia
(distance) (direction) (nearest town)

WELL PURPOSE: Home
(home, irrigation, municipal, industrial)

WELL COMPLETION DATA:

- (1) diameter (inches) 2"
- (2) total depth (feet) 180'
- (3) static water level (feet) 140' below top of ground.
- (4) casing galv. 175' (material) (depth)
If telescope see back.
- (5) screen 5' 180' (length) (depth to top)
2" Johnson Stainless (size) (material)
- (6) pump 3/4 Rod 10 (HP) (yield gpm)
110 (type power)
- (7) electric log No (yes or no)
(organization running log)
- (8) how well bottom plugged Back Wash Valve


ADDED

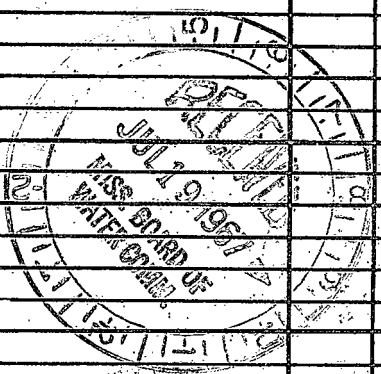

DRILLERS REMARKS:

If well telescopes please sketch and show depths.

GROUND LEVEL

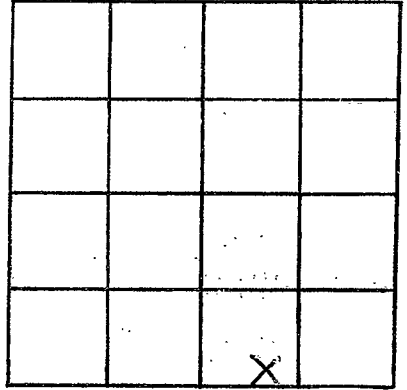

SECTION 21

Please indicate well location X.

ADDITIONAL INFORMATION

If more than one screen, show locations of each on sketch.