

MISSISSIPPI  
 BOARD OF WATER COMMISSIONERS  
 416 North State Street  
 Jackson, Mississippi 39201  
 WATER WELL DRILLERS LOG

Walthall  
 24  
 6-67

6/2 1967 Andis Drilling Co. Walthall  
 date well completed firm name county well located


LANDOWNER: Joseph Stegler  
Rt. 2 Tubertown  
Miss. 39664  
 (mailing address)

WELL LOCATION:  
 sec. 18 T. 2 N. R. 13 E.  
5 miles S.E. of Dexter  
 (distance) (direction) (nearest town)

WELL PURPOSE: Home  
 (home, irrigation, municipal, industrial)

WELL COMPLETION DATA:  
 (1) diameter (inches) 4"  
 (2) total depth (feet) 130'  
 (3) static water level (feet) 13' below above top of ground.  
 (4) casing P.V.C. 124'  
 (material) (depth)  
4" if telescope see back.  
 (size)  
 (5) screen 6' 130'  
 (length) (depth to top)  
4" P.V.C.  
 (size) (material)  
 (6) pump 1 10  
 (HP) (yield gpm)  
R.E.A. 220  
 (type power)  
 (7) electric log No  
 (yes or no)  
 (organization running log)  
 (8) how well bottom plugged Back  
Wash Valve


description of fomations encountered	from	to
<u>Red clay</u>	<u>0'</u>	<u>30'</u>
<u>Sand</u>	<u>30'</u>	<u>60'</u>
<u>Gravel</u>	<u>60'</u>	<u>70'</u>
<u>Chalk</u>	<u>70'</u>	<u>80'</u>
<u>Sand</u>	<u>80'</u>	<u>110'</u>
<u>Coarse sand / fine gravel</u>	<u>110'</u>	<u>130'</u>

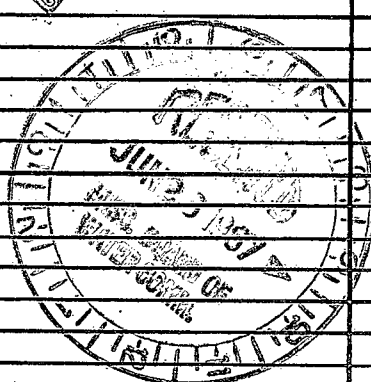

DRILLERS REMARKS:

If well telescopes please sketch and show depths.

GROUND LEVEL

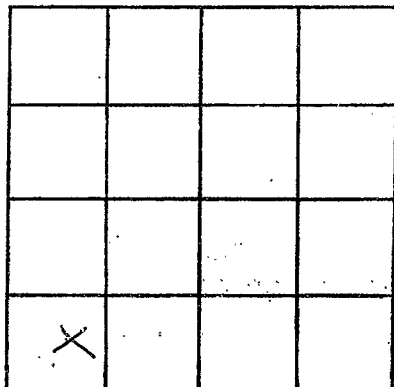

SECTION 18

Please indicate well location X.

ADDITIONAL INFORMATION

If more than one screen, show locations of each on sketch.