

Walthall
 25
 12-68

MISSISSIPPI
 BOARD OF WATER COMMISSIONERS
 416 North State Street
 Jackson, Mississippi 39201

COPIES

WATER WELL DRILLERS LOG

December 19 68 Essley Stafford Walthall
 date well completed firm name county well located


LANDOWNER:	description of formations encountered	from	to
Houston Thomas			
Rt 2 Sandy Hook (mailing address)	Chalk & Red sand str Gravel & sand	0 90	90 130
WELL LOCATION:			
sec. 9 T 1 N R 13 E S W			
1 1/2 miles N of IMPROVE (distance) (direction) (nearest town)			
WELL PURPOSE: home (home, irrigation, municipal, industrial)			
WELL COMPLETION DATA:			
(1) diameter (inches) 4"			
(2) total depth (feet) 130'			
(3) static water level (feet) 120' ^{below} above top of ground.			
(4) casing (material) (depth) Plas. 120' 4" (size) if telescope see back.			
(5) screen (length) (depth to top) 10' 120' 4" (size) Plastic (material)			
(6) pump (HP) (yield gpm) 1/2 600 Elec 6 FT (type power)			
(7) electric log NO (yes or no)			
(organization running log)			
(8) how well bottom plugged BWV			
DRILLERS REMARKS:			

INDEX

Received
 March 18, 1969
 in office

If well telescopes please sketch and show depths.

GROUND LEVEL

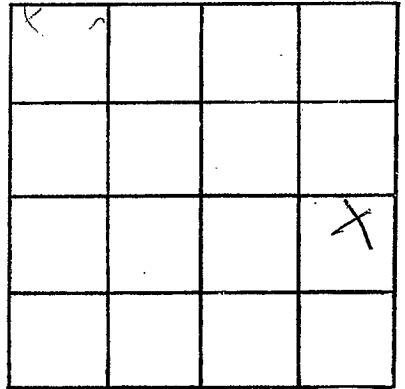

SECTION 9

Please indicate well location X.

ADDITIONAL INFORMATION

If more than one screen,
show locations of each on sketch.