

**MISSISSIPPI  
BOARD OF WATER-COMMISSIONERS**  
416 North State Street  
Jackson, Mississippi 39201

**CODED**

**WATER WELL DRILLERS LOG**

Walthall  
LG  
9-24-69

Sept. 24 1969 Harold Walthall Walthall  
date well completed firm name county well located


| LANDOWNER:   | description of formations encountered                           | from       | to           |
|--|---|------------|--------------|
| <u>W. L. Crum</u><br><u>Rt. 2</u>  | <u>Red Clay</u>   | <u>0</u>   | <u>13</u>    |
| <u>Sandy Hook, Miss.</u><br>(mailing address)  | <u>Red sand</u>   | <u>17</u>  | <u>35</u>    |
| WELL LOCATION:<br>sec. <u>18</u> T. <u>1</u> N R. <u>13</u> E<br>S W                 | <u>Large soft Rocks</u><br><u>and fine pink sand</u>            | <u>36</u>  | <u>50</u>    |
| <u>18</u> miles <u>C</u> of <u>Walthall</u><br>(distance) (direction) (nearest town) | <u>Choke sand &amp;</u><br><u>soft Rocks</u>                    | <u>50</u>  | <u>85 ft</u> |
| WELL PURPOSE:<br>(home, irrigation, municipal, industrial)                           | <u>set at 85 ft. would not</u><br><u>give up a enough water</u> |            |              |
| WELL COMPLETION DATA:<br>(1) diameter (inches) <u>4"</u>                             | <u>Purple Clay</u>  | <u>90</u>  | <u>105</u>   |
| (2) total depth (feet) <u>148 ft.</u>  | <u>Round fine sand</u>  | <u>105</u> | <u>126</u>   |
| (3) static water level (feet) <u>60</u> below<br>top of ground.                      | <u>Choke sand &amp; large</u><br><u>rocks</u>                   | <u>130</u> | <u>160</u>   |
| (4) casing <u>plastic</u> <u>148 ft.</u><br>(material) (depth)                       |   |            |              |
| <u>4"</u> if telescope see back.<br>(size)   |   |            |              |
| (5) screen <u>10 ft.</u> (length) (depth to top)                                     |   |            |              |
| <u>4"</u> (size) <u>plastic</u> (material)   |   |            |              |
| (6) pump <u>1/2 hp</u> <u>S.P.H. 650</u><br>(HP) (yield gpm)                         | <u>set at 148 ft.</u>   |            |              |
| <u>230 AC</u><br>(type power)  |   |            |              |
| (7) electric log <u>no</u><br>(yes or no)  |   |            |              |
| <u>Self</u><br>(organization running log)  |   |            |              |
| (8) how well bottom plugged <u>2" B.W.</u><br><u>level</u>                           |   |            |              |

DRILLERS REMARKS: None

1970  
MISSISSIPPI  
STATE  
COMM.

If well telescopes please sketch and show depths.

GROUND LEVEL

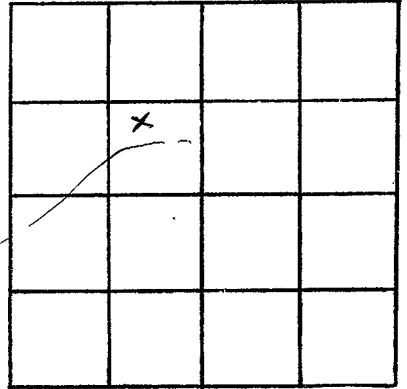

SECTION 18

Please indicate well location X.

ADDITIONAL INFORMATION

*all the state wells  
that I have drilled have  
I found to be very  
hard to make*

*Frank Woodard*

If more than one screen,  
show locations of each on sketch.