

No log  
in file  
2170

Walthall  
L 7,  
10-14-69

MISSISSIPPI  
BOARD OF WATER COMMISSIONERS  
416 North State Street  
Jackson, Mississippi 39201

WATER WELL DRILLERS LOG

CODED

10-14-69 19  
date well completed

Essley Stafford  
firm name

Walthall  
county well located

LANDOWNER: Jerry Thomas

description of formations encountered

from

to

Sandy Hook, Miss  
(mailing address)

sand

0

153 ft

WELL LOCATION:

sec. 16 T 1 N R 13 E  
# miles S of Sandy Hook  
(distance) (direction) (nearest town)

WELL PURPOSE:

(home, irrigation, municipal, industrial)

WELL COMPLETION DATA:

- (1) diameter (inches) 4 in
- (2) total depth (feet) 153 ft
- (3) static water level (feet) 30 below above top of ground.
- (4) casing Plastic, 153 (material) (depth)  
4 in if telescope see back. (size)
- (5) screen 10 ft, 143 ft (length) (depth to top)  
4 in Plastic (size) (material)
- (6) pump 1/2 HP, 900 gpm (HP) (yield gpm)  
115 V (type power) 6 1/2 2 3/4
- (7) electric log Yes (yes or no)

CODED

(organization running log)

(8) how well bottom plugged B.W.V.

DRILLERS REMARKS:


Charles Stafford

OCT 20 1969

FILE NO. OF  
WATER BOARD

If well telescopes please sketch and show depths.

GROUND LEVEL

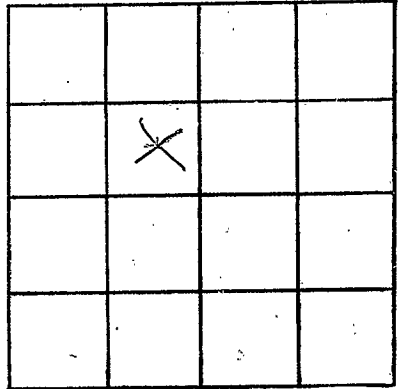

SECTION 16

Please indicate well location X.

ADDITIONAL INFORMATION

If more than one screen, show locations of each on sketch.