

no log
in file
2170

Walthall
L8
10-3-69

MISSISSIPPI
BOARD OF WATER COMMISSIONERS
416 North State Street
Jackson, Mississippi 39201

WATER WELL DRILLERS LOG

CODED
Walthall
county well located

10-3-69 19
date well completed

Essley Stafford
firm name

LANDOWNER: Smith, Brumfield

description of formations encountered

from to

Sandy Hook Miss
(mailing address)

sand 0 2.5ft

chalk 25 35ft

WELL LOCATION:
sec. 10 T 1 N R 13 E
S W

sand 35 8.5ft

5 miles W of Sandy Hook
(distance) (direction) (nearest town)

WELL PURPOSE:
(home, irrigation, municipal, industrial)

WELL COMPLETION DATA:

- (1) diameter (inches) 4 in
- (2) total depth (feet) 8.5 ft
- (3) static water level (feet) 65 below above top of ground.
- (4) casing Plastic, 8.5 ft (material) (depth)
4 in (size) if telescope see back.
- (5) screen 10 ft, 7.5 ft (length) (depth to top)
4 in, Plastic (size) (material)
- (6) pump 1/2 HP, 300 gpm (HP) (yield gpm)
110 W (type power)
- (7) electric log Yes (yes or no)
- (organization running log)
- (8) how well bottom plugged B.W.V.

CODED


OCT 29 1969

Miss. Bd. of
WATER COMMISSIONERS

DRILLERS REMARKS:
Charles Stafford

If well telescopes please sketch and show depths.

GROUND LEVEL

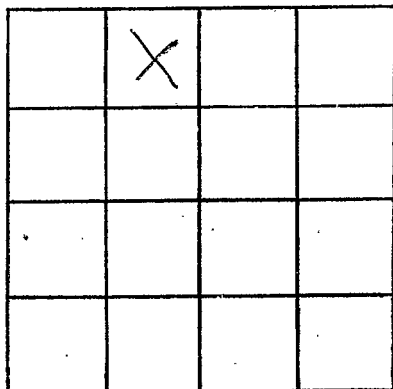

SECTION 9

Please indicate well location X.

ADDITIONAL INFORMATION

If more than one screen,
show locations of each on sketch.