

MISSISSIPPI
BOARD OF WATER COMMISSIONERS
416 North State Street
Jackson, Mississippi 39201

CODED

WATER WELL DRILLERS LOG

WALTHALL
L 9
11- 69

Nov. 19 69 date well completed E. B. Sheppard firm name Walthall county well located

LANDOWNER:	description of formations encountered	from	to
<u>L. T. Jackson</u> <u>Sandy Hook, Miss.</u> (mailing address)			
WELL LOCATION:			
sec. <u>8</u> T. <u>1</u> N. R. <u>13</u> W. <u>14</u> miles <u>ESE</u> of <u>Dyersburg</u> (distance) (direction) (nearest town)			
WELL PURPOSE: (home, irrigation, municipal, industrial)			
WELL COMPLETION DATA:			
(1) diameter (inches) <u>2"</u>			
(2) total depth (feet) <u>143'</u>			
(3) static water level (feet) <u>110</u> below above top of ground.			
(4) casing <u>Plastic</u> , <u>143'</u> (material) (depth)			
<u>2"</u> (size) if telescope see back.			
(5) screen <u>3'</u> (length) (depth to top)			
<u>2 1/2"</u> <u>S.S.</u> (size) (material)			
(6) pump <u>1 1/2</u> <u>8</u> (HP) (yield gpm)			
(type power)			
(7) electric log <u>(yes or no)</u>			
(organization running log)			
(8) how well bottom plugged <u>DN</u>			
DRILLERS REMARKS:			


CODED

EEB E 1070

MISS. BU. OF WATER COMMISSIONERS

If well telescopes please sketch and show depths.

GROUND LEVEL

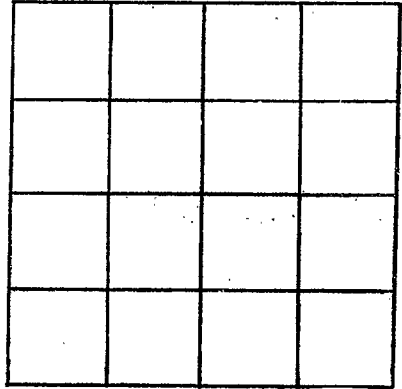

SECTION _____

Please indicate well location X.

ADDITIONAL INFORMATION

If more than one screen, show locations of each on sketch.