

CODED

MISSISSIPPI
BOARD OF WATER COMMISSIONERS
416 North State Street
Jackson, Mississippi 39201

WATER WELL DRILLERS LOG

Walthall
L 10
2-18-70

2/18 1970 Dean Lines Walthall
date well completed firm name county well located

LANDOWNER:

Edro Brock

description of formations encountered

Top soil

from to

0-1

Route 2 Sandyhook
(mailing address)

Red Clay

1-30

WELL LOCATION:

sec. 26 T 1 N R 12 S W
5 miles W of Sandyhook
(distance) (direction) (nearest town)

Red clay

30-50

Gravel

50-90

Chalk

90-120

WELL PURPOSE: Home Use
(home, irrigation, municipal, industrial)

Water use 120-157

WELL COMPLETION DATA:

- (1) diameter (inches) 2"
- (2) total depth (feet) 151'
- (3) static water level (feet) 125' below top of ground.
- (4) casing Plastic 142'
(material) (depth)
if telescope see back.
- (5) screen 7' 144'
(length) (depth to top)
2" Plastic
(size) (material)
- (6) pump 1 H.P. jacuzzi jet pump
(HP) (yield gpm)
(type power)
- (7) electric log No
(yes or no)

CODED

(organization running log)

(8) how well bottom plugged


DRILLERS REMARKS:

MAR 18 1970

MISS. BD. OF
WATER COMM

If well telescopes please sketch and show depths.

GROUND LEVEL

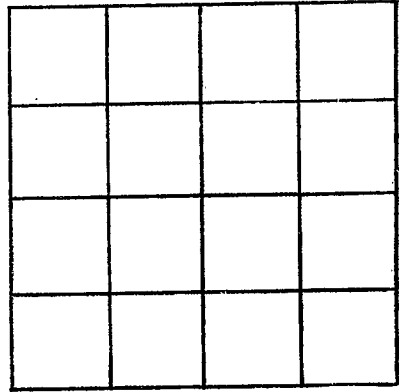

SECTION _____

Please indicate well location X.

ADDITIONAL INFORMATION

If more than one screen, show locations of each on sketch.