

CODED

MISSISSIPPI  
BOARD OF WATER COMMISSIONERS  
416 North State Street  
Jackson, Mississippi 39201

WALTRALL  
L 11  
8-19-70

WATER WELL DRILLERS LOG

Aug 19 1970 Ernie Stafford's Water well Service Waltrall  
date well completed firm name county well located

LANDOWNER: W. E. Dykes

description of formations encountered from to

Montpelier, La.  
(mailing address)

Chalk 0 15

WELL LOCATION:  
sec. 23 T 1 N R 13 E 263  
3 miles East of Imperial  
(distance) (direction) (nearest town)

Sand + Gravel 15 147

WELL PURPOSE:  
(home, irrigation, municipal, industrial)

WELL COMPLETION DATA:

- (1) diameter (inches) 4 in
- (2) total depth (feet) 147
- (3) static water level (feet) 107 below top of ground.
- (4) casing Plastic, 137  
(material) (depth)  
4 in if telescope see back.  
(size)
- (5) screen 10 ft, 137 ft  
(length) (depth to top)  
4 in, Plastic  
(size) (material)
- (6) pump 1/2 70  
(HP) (yield gpm)  
Elec  
(type power)
- (7) electric log \_\_\_\_\_  
(yes or no)  
  
(organization running log)
- (8) how well bottom plugged B.W.V.

CODED


AUG 31 1970

DRILLERS REMARKS:  
Clive Duncan

MISS. BD. OF  
WATER COMM.

If well telescopes please sketch and show depths.

GROUND LEVEL

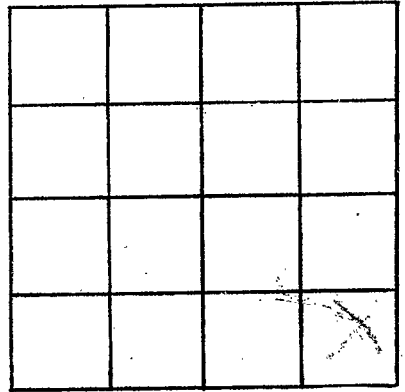

SECTION \_\_\_\_\_

Please indicate well location X.

ADDITIONAL INFORMATION

If more than one screen, show locations of each on sketch.