

Walthall
L 12
10-70

MISSISSIPPI
BOARD OF WATER COMMISSIONERS
416 North State Street
Jackson, Mississippi 39201

CODED

WATER WELL DRILLERS LOG

date well completed Oct 19 70 firm name FORNER Drilling Serv. Inc county well located Walthall

LANDOWNER: IMPROVE
Water Ass'n.
Tybertown Miss
(mailing/address)

description of formations encountered	from	to
<u>Top Soil</u>	<u>0</u>	<u>2</u>
<u>Clay</u>	<u>2</u>	<u>30</u>
<u>SAND & GRAVEL</u>	<u>30</u>	<u>164</u>
<u>Clay</u>	<u>164</u>	<u>320</u>
<u>SAND</u>	<u>320</u>	<u>1108</u>

WELL LOCATION:
sec. 8 T. 14 N. R. 13 E
S W
8 miles SE of Tybertown
(distance) (direction) (nearest town)

WELL PURPOSE: Municipal
(home, irrigation, municipal, industrial)

- WELL COMPLETION DATA:
- (1) diameter (inches) 8
 - (2) total depth (feet) 406
 - (3) static water level (feet) 125 below top of ground.
 - (4) casing Steel 330'
(material) (depth)
8 if telescope see back.
(size)
 - (5) screen 60 346'
(length) (depth to top)
6" 5.5'
(size) (material)
 - (6) pump 25 350
(HP) (yield gpm)
Elec
(type power)
 - (7) electric log YES
(yes or no)
MIS.
(organization running log)
 - (8) how well bottom plugged Back
Wash Water

CODED


SEP 24 1970

MISS. BD. OF
WATER COMM.

DRILLERS REMARKS:

If well telescopes please sketch and show depths.

GROUND LEVEL

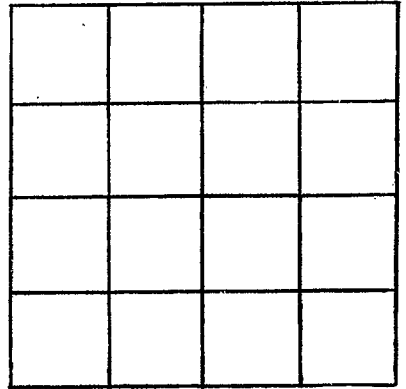

SECTION _____

Please indicate well location X.

ADDITIONAL INFORMATION

If more than one screen, show locations of each on sketch.