

MISSISSIPPI
BOARD OF WATER COMMISSIONERS
416 North State Street
Jackson, Mississippi 39201

CODED

WATER WELL DRILLERS LOG

Dean Times Water
Well Service

Walthall

Walthall
L 13
6-30-70

6-30-70 19
date well completed

firm name

county well located

LANDOWNER:

James M. Davit
Route 2 Sandhock, Miss
(mailing address)

description of formations encountered

from to

top soil 0-1"
Clay 1-6
sand 6-47
Chalk 47-67
Water sand 67-95

WELL LOCATION:

sec. *20* T. *1* N. R. *13* E.
1 miles *South* of *Lithington*
(distance) (direction) (nearest town)

WELL PURPOSE: *Home Use*
(home, irrigation, municipal, industrial)

WELL COMPLETION DATA:

- (1) diameter (inches) *4"*
- (2) total depth (feet) *95'*
- (3) static water level (feet) *75'* below top of ground.
- (4) casing *Plastic*, *85'* (material) (depth)
If telescope see back.
(size)
- (5) screen *10"*, *85'* (length) (depth to top)
4", *Plastic* (size) (material)
- (6) pump *1/2 HP* (HP) (yield gpm)
(type power)
- (7) electric log (yes or no)
(organization running log)
- (8) how well bottom plugged

CODED


JUL 20 1970

DRILLERS REMARKS:

MISS. BD. OF
WATER COMMISSIONERS

If well telescopes please sketch and show depths.

GROUND LEVEL

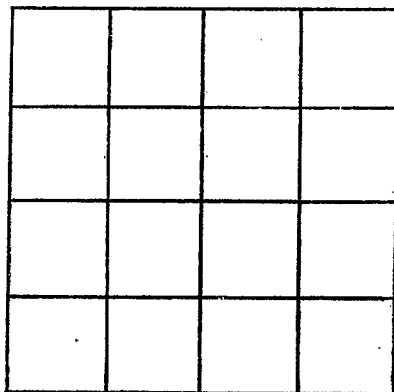

SECTION _____

Please indicate well location X.

ADDITIONAL INFORMATION

If more than one screen, show locations of each on sketch.