

MISSISSIPPI  
BOARD OF WATER COMMISSIONERS  
416 North State Street  
Jackson, Mississippi 39201

**CODED**

WALTHALL  
L 14  
4-20-71

WATER WELL DRILLERS LOG

April 20 1971 date well completed  
Easley Stafford Well Drilling firm name  
Walthall county well located

| LANDOWNER:   | description of formations encountered | from | to  |
|--|---------------------------------------|------|-----|
|  |                                       |      |     |
| W. J. Stagner  |                                       |      |     |
| Sandy Hook Miss (mailing address)                                | Clay                                  | 1    | 15  |
| WELL LOCATION:   | Chalk                                 | 15   | 50  |
| sec. 17 T 1 N R 13 E   | Sand + Gravel                         | 50   | 115 |
| 5 miles West of Sandy Hook (distance) (direction) (nearest town) |                                       |      |     |
| WELL PURPOSE:<br>(home, irrigation, municipal, industrial)       |                                       |      |     |
| WELL COMPLETION DATA:  |                                       |      |     |
| (1) diameter (inches) 4 in                                       |                                       |      |     |
| (2) total depth (feet) 11.5 ft                                   |                                       |      |     |
| (3) static water level (feet) _____ below above top of ground.   |                                       |      |     |
| (4) casing Plastic 105 (material) (depth)                        |                                       |      |     |
| 4 in if telescope see back. (size)                               |                                       |      |     |
| (5) screen 10 ft 105 ft (length) (depth to top)                  |                                       |      |     |
| 4 in Plastic (size) (material)                                   |                                       |      |     |
| (6) pump 1/2 900 hp (HP) (yield gpm)                             |                                       |      |     |
| Elec. (type power)   |                                       |      |     |
| (7) electric log _____ (yes or no)                               |                                       |      |     |
| (organization running log)                                       |                                       |      |     |
| (8) how well bottom plugged B.W.V.                               |                                       |      |     |
| DRILLERS REMARKS:  |                                       |      |     |
| Charles Stafford   |                                       |      |     |


**CODED**

MAY 27 1971

MISS. Bd. OF WATER COMM.

If well telescopes please sketch and show depths.

GROUND LEVEL

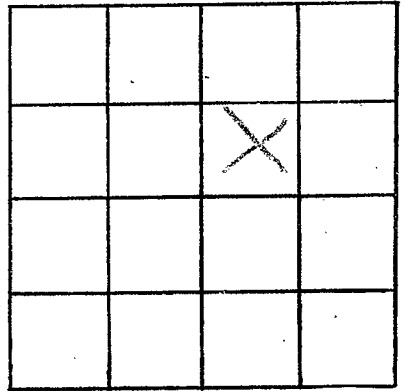

SECTION \_\_\_\_\_

Please indicate well location X.

ADDITIONAL INFORMATION

If more than one screen, show locations of each on sketch.