

WALTHAM  
L 15  
5-1-71

MISSISSIPPI  
BOARD OF WATER COMMISSIONERS  
416 North State Street  
Jackson, Mississippi 39201

**CODED**

WATER WELL DRILLERS LOG

May 1 1971 Harold Woodward Walthe  
date well completed firm name county well located

LANDOWNER: Bonnie Williams  
Rt. 2 Sandy Hook  
Miss.  
(mailing address)

WELL LOCATION:  
sec. 32 T 1 N R 13 E  
21 miles East of Tipton  
(distance) (direction) (nearest town)

WELL PURPOSE:  
(home, irrigation, municipal, industrial)

- WELL COMPLETION DATA:
- (1) diameter (inches) 4"
  - (2) total depth (feet) 162 ft.
  - (3) static water level (feet) 100 below top of ground. above
  - (4) casing plastic 152'  
(material) (depth)  
(size) if telescope see back.
  - (5) screen 10' 152'  
(length) (depth to top)  
(size) (material)
  - (6) pump 3/4 750  
(HP) (yield gpm)  
(type power)
  - (7) electric log no  
(yes or no)  
yes  
(organization running log)
  - (8) how well bottom plugged

description of formations encountered	from	to
<u>Red clay</u>	<u>0'</u>	<u>25'</u>
<u>Red sand</u>	<u>25'</u>	<u>38'</u>
<u>white clay</u>	<u>38'</u>	<u>120'</u>
<u>fine sand</u>	<u>120'</u>	<u>135'</u>
<u>Chrome sand</u>	<u>135'</u>	<u>162'</u>
<u>Sand &amp; gravel</u>	<u>162'</u>	

**CODED**

Set in very good formation


JUN 23 1971

MISS. BD. OF  
WATER COMMISSIONERS

DRILLERS REMARKS:

If well gauges please sketch and show depths.

GROUND LEVEL

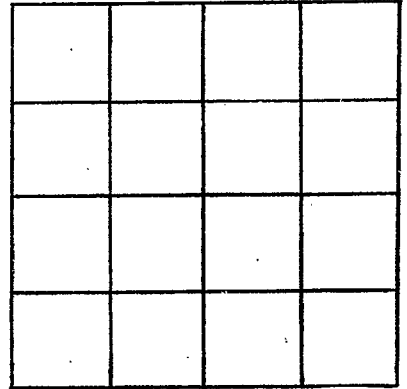

SECTION \_\_\_\_\_

Please indicate well location X.

ADDITIONAL INFORMATION

If more than one screen, show locations of each on sketch.