

WALTHALL
L 16.
6-29-71

MISSISSIPPI
BOARD OF WATER COMMISSIONERS
416 North State Street
Jackson, Mississippi 39201

CODED

WATER WELL DRILLERS LOG

June 29 1971 *Harold Woodward* *Walthall*
date well completed firm name county well located

LANDOWNER: *Danny B. yelaud*
RT. 2
Sandyhook Miss.
(mailing address)

description of formations encountered	from	to
<i>Red clay</i>	<i>0</i>	<i>17</i>
<i>brown sand</i>	<i>18</i>	<i>26</i>
<i>chown white sand & gravel</i>	<i>26</i>	<i>39'</i>

WELL LOCATION:
sec. *31* T. *1* N. R. *13* E
15 miles *SE* of *Tylertown*
(distance) (direction) of (nearest town)

WELL PURPOSE: *home*
(home, irrigation, municipal, industrial)

CODED

WELL COMPLETION DATA:

(1) diameter (inches) *4"*

(2) total depth (feet) *39 ft.*

(3) static water level (feet) *14* below top of ground.

(4) casing *plastic* *34'*
(material) (depth)
(size) if telescope see back.

(5) screen *5"* *34'*
(length) (depth to top)
4"
(size) (material)

(6) pump *1/2* *10*
(HP) (yield gpm)
230V
(type power)

(7) electric log *no*
(yes or no)
Self
(organization running log)

(8) how well bottom plugged *2" 55*
BW units

*set in
level
formation*


JUL 7 1971
MISSISSIPPI
WATER BOARD

*Del
Harold
Woodward*

DRILLERS REMARKS:

If well telescopes please sketch and show depths.

GROUND LEVEL

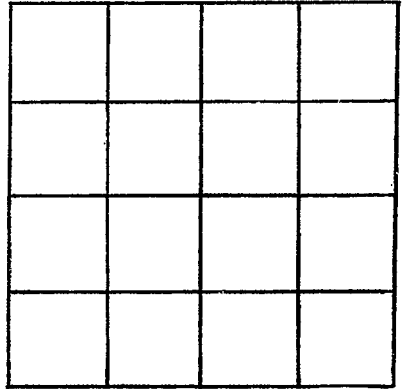

SECTION _____

Please indicate well location X.

ADDITIONAL INFORMATION

If more than one screen,
show locations of each on sketch.