

CODED

FEB 17 1972

WALTHALL
L 17
1-22-72

MISSISSIPPI
BOARD OF WATER COMMISSIONERS
416 North State Street
Jackson, Mississippi 39201

WATER WELL DRILLERS LOG

Well Service
Walthall

1-22 1972 Essley Stafford Water firm name
date well completed county well located

LANDOWNER: Tommy Walker
Rt 7

description of formations encountered

from to

Lybertown Miss
(mailing address)

Topsoil 1 15

WELL LOCATION:
sec. 22 T 1 N R 13 E
1/2 miles S.E. of Laprov
(distance) (direction) (nearest town)

Red Clay 15 20

Sand & Gravel 20 130

WELL PURPOSE:
(home, irrigation, municipal, industrial)

WELL COMPLETION DATA:


- (1) diameter (inches) 4
- (2) total depth (feet) 130
- (3) static water level (feet) 20 below above top of ground.
- (4) casing Plastic 120 ft
(material) (depth)
- 4 in if telescope see back.
(size)
- (5) screen 10 120 ft
(length) (depth to top)
- 4 in Plastic
(size) (material)
- (6) pump 1/2 10
(HP) (yield gpm)
- Elec
(type power)
- (7) electric log (no)
(yes or no)
- (organization running log)
- (8) how well bottom plugged B.W.V.

CODED

DRILLERS REMARKS:
Cleve Duncan

If well telescopes please sketch and show depths.

GROUND LEVEL

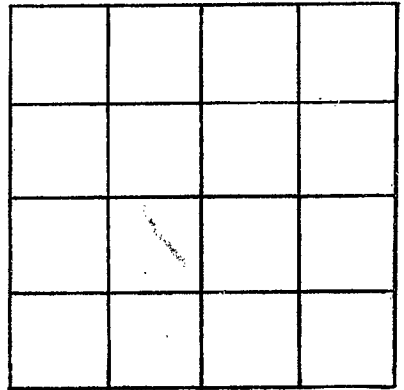

SECTION _____

Please indicate well location X.

ADDITIONAL INFORMATION

If more than one screen, show locations of each on sketch.