

**CODED**

MISSISSIPPI  
BOARD OF WATER COMMISSIONERS

FEB 29 1972

416 North State Street

Jackson, Mississippi 39201

WATER WELL DRILLERS LOG

WALTHALL

L 18

1-25-72

1-25-72 x RALPH Cotton

Walthall

date well completed

firm name

county well located

LANDOWNER: John Ireland

description of formations encountered

from

to

Route 1, Paul

Red Clay

0 30

Sandy Hook Miss  
(mailing address)

Chalk

30 75

WELL LOCATION:

sec. 22T 1 N R. 13 E

4 miles S of Sandy Hook  
(distance) (direction) (nearest town)

Sand & Gravel

75 123

WELL PURPOSE:

(home, irrigation, municipal, industrial)

WELL COMPLETION DATA:

- (1) diameter (inches) 2 in
- (2) total depth (feet) 123
- (3) static water level (feet) 80 below top of ground.

- (4) casing Galv. (material), 119 (depth)

2 (size) if telescope see back.

- (5) screen 5 ft (length), 118 ft (depth to top)

2 in (size), Stainless Steel (material)

- (6) pump (HP) (yield gpm)

(type power) Used old pump

- (7) electric log (yes or no)

(organization running log)

- (8) how well bottom plugged B.W.U.


**CODED**

DRILLERS REMARKS:

Ralph Cotton

If well telescopes please sketch and show depths.

GROUND LEVEL

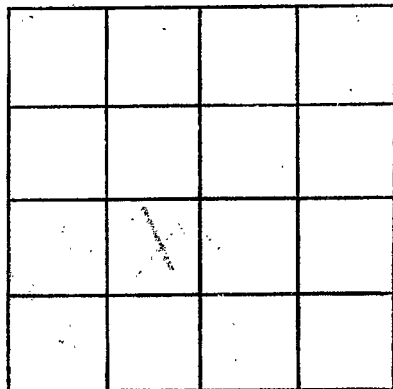

SECTION \_\_\_\_\_

Please indicate well location X.

ADDITIONAL INFORMATION

If more than one screen, show locations of each on sketch.