

WALTHALL  
L 21  
9-12-72

MISSISSIPPI  
BOARD OF WATER COMMISSIONERS  
416 North State Street  
Jackson, Mississippi 39201

WATER WELL DRILLERS LOG

**CODED**

Sept 12 1972 date well completed  
Chester Keenes firm name  
Walthall county well located

LANDOWNER: Ray Parrott  
RFD - 1  
Sandy Hook -  
(mailing address)

description of formations encountered	from	to
Red clay	2	13
Red sand	13	100
Sand & gravel	100	118

WELL LOCATION:  
sec. 21 T 1 N R 13 E  
6 miles ESE of Dexter  
(distance) (direction) (nearest town)

WELL PURPOSE: Home  
(home, irrigation, municipal, industrial)

- WELL COMPLETION DATA:
- (1) diameter (inches) 4"
  - (2) total depth (feet) 118
  - (3) static water level (feet) 18 below top of ground.
  - (4) casing Plastic Ballou (material) (depth)
  - (size) if telescope see back.
  - (5) screen 6' 117 (length) (depth to top)  
1/2" Plast (size) (material)
  - (6) pump 1/2 HP 15 (HP) (yield gpm)  
Elect (type power)
  - (7) electric log NO (yes or no)
  - (organization running log)


**CODED**

(8) how well bottom plugged  
wood plug  
DRILLERS REMARKS:  
New house.

DEC 1 1972

If well telescopes please sketch and show depths.

GROUND LEVEL

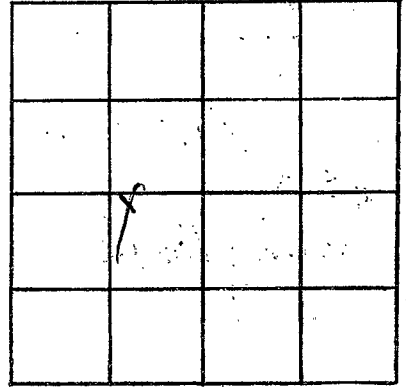

SECTION 21

Please indicate well location X.

ADDITIONAL INFORMATION

If more than one screen, show locations of each on sketch.