

WALTHALL
L 23
12-7-74

MISSISSIPPI
BOARD OF WATER COMMISSIONERS
416 North State Street
Jackson, Mississippi 39201

CODED

WATER WELL DRILLERS LOG
GRINER - GINN

Walthall


12-7-74
date well completed

GRINER - GINN
firm name

Walthall
county well located

LANDOWNER:	description of formations encountered	from	to
Quinn Herrick Rt. 2 Sulentown (mailing address) Miss			
WELL LOCATION:			
sec. 11 T. 10 R. 13 8 miles SE of Lakona (distance) (direction) (nearest town)			
WELL PURPOSE: Home (home, irrigation, municipal, industrial)			
WELL COMPLETION DATA:			
(1) diameter (inches) 2"			
(2) total depth (feet) 103			
(3) static water level (feet) 35 below top of ground.			
(4) casing plastic, 93 (material) (depth) 2" If telescope see back. (size)			
(5) screen 10', 93 (length) (depth to top) 2" plastic (size) (material)			
(6) pump 1 6 (HP) (yield gpm) e/c.e. (type power)			
(7) electric log NO (yes or no) NO (organization running log)			
(8) how well bottom plugged B-W. Valve			
DRILLERS REMARKS:			

CODED

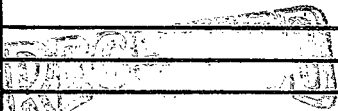


MAY 22 1974

MISS. RD. OF WATER COMMISSIONERS

If well telescopes please sketch and show depths.

GROUND LEVEL

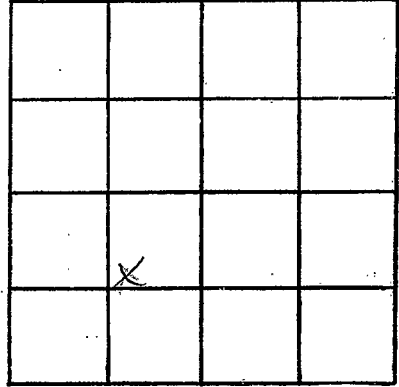

SECTION 71

Please indicate well location X.

ADDITIONAL INFORMATION

If more than one screen, show locations of each on sketch.