

WALTHALL
L 24
1-11-74

MISSISSIPPI
BOARD OF WATER COMMISSIONERS
416 North State Street
Jackson, Mississippi 39201

CODED

WATER WELL DRILLERS LOG

GRINER - GINN

Walthall

1-11 date well completed

firm name

county well located

LANDOWNER:

Mrs Lula Green
Rt. 2, Box 115, Dulentown
(mailing address) Miss.

description of formations encountered

from to

Top Soil	0	1
Clay	1	42
Clay Sand + gravel	42	122
Sand	122	155

WELL LOCATION:

sec. 9 T. 1 N. R. 13 E.
4 miles S of Kokomo
(distance) (direction) (nearest town)

WELL PURPOSE: HOME
(home, irrigation, municipal, industrial)

WELL COMPLETION DATA:

- (1) diameter (inches) 2"
- (2) total depth (feet) 155
- (3) static water level (feet) 110 below above top of ground.
- (4) casing plastic, 145, (material) (depth)
2" (size) If telescope see back.
- (5) screen 10' 145 (length) (depth to top)
2" plastic (size) (material)
- (6) pump 1 1/2 6 (HP) (yield gpm)
elec. (type power)
- (7) electric log NO (yes or no)
No (organization running log)
- (8) how well bottom plugged
B.W. Valve


CODED

DRILLERS REMARKS:

MISS. Bd. OF WATER COMMISSIONERS

If well telescopes please sketch and show depths.

GROUND LEVEL

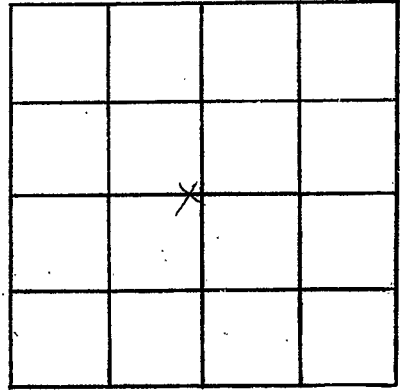

SECTION 9

Please indicate well location X.

ADDITIONAL INFORMATION

If more than one screen, show locations of each on sketch.