

MISSISSIPPI DEPARTMENT OF NATURAL RESOURCES

Bureau of Land and Water Resources

Southport Mall

P.O. Box 10631

Jackson, Mississippi 39209

WATER WELL DRILLERS LOG

CODED

WALTHALL  
L 29  
9/15/82

Sept 15 1982 News Wellr Walthall  
date well completed firm name county well located

LANDOWNER: Joe Pittman  
147 Tylertown (mailing address)

description of formations encountered	from	to
Darky Clay	0	20
Red sand	20	65
Red Chalk	65	80
Red sand	80	125
sand & flint gravel	125	190
blue chalk	190	285
sand & gravel	285	315

WELL LOCATION: sec. 6 T. 1 N. R. 13 E.  
1.4 miles E-SE of Tylertown (distance) (direction) (nearest town)

WELL PURPOSE: industrial (home, irrigation, municipal, industrial)

- WELL COMPLETION DATA:
- (1) diameter (inches) 4"
  - (2) total depth (feet) 315
  - (3) static water level (feet) 90 below top of ground
  - (4) casing plastic bottom (material) (depth)
  - (5) screen 20' 295' (length) (depth to top)  
4" plastic (size) (material)
  - (6) pump Origo 100 (HP) (yield gpm)  
gas (type power)
  - (7) electric log no (yes or no)
  - (organization running log)

(8) how well bottom plugged back wash

DRILLERS REMARKS:


DEPT. OF NATURAL RESOURCES  
BUREAU OF LAND & WATER RESOURCES

JAN 13 1983

RECEIVED

If well telescopes please sketch and show depths.

GROUND LEVEL

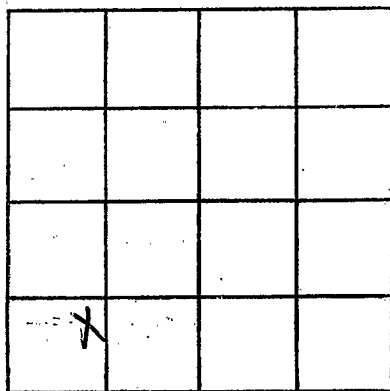

SECTION b

Please indicate well location X.

ADDITIONAL INFORMATION

If more than one screen, show locations of each on sketch.