

MISSISSIPPI DEPARTMENT OF NATURAL RESOURCES

Bureau of Land and Water Resources

Southport Mall

P.O. Box 10631

Jackson, Mississippi 39209 **CODED**

WATER WELL DRILLERS LOG

TOM GRIFFITH

PLUMBING & WELL SERVICE, INC.

320 MAYSON AVE.

county well located

WALTHALL
L-30
8-9-85

8-9 19 85
date well completed

Walthall

LANDOWNER: Wilson Brother's Drilling

P.O. Drawer 53628

La Fayette, LA 70505
(mailing address)

WELL LOCATION:

sec. 6 T 1 N R 13 E
S W

12 miles SE of Tyertown
(distance) (direction) (nearest town)

WELL PURPOSE: oil LOC
(home, irrigation, municipal, industrial)

WELL COMPLETION DATA:

- (1) diameter (inches) 4"
- (2) total depth (feet) 420'
- (3) static water level (feet) 60' below top of ground.
- (4) casing Steel, 38' (material) (depth)
- N/A (size) if telescope see back.
- (5) screen 40' (length), 50' + 380' (depth to top)
- 4" slot (size) (material)
- (6) pump airlift 80 (HP) (yield gpm)
- diesel (type power)
- (7) electric log NO (yes or no)
- N/A (organization running log)
- (8) how well bottom plugged BWV

description of formations encountered

from

to

Red Sand	1'	80'
Gravel	80'	120'
Clay	120'	180'
Sand	180'	420'

#10CHANT

500' S + 425' W of

WE/DR 316-1N-13E

DRILLERS REMARKS:


Department of Natural Resources
Bureau of Land & Water Resources

RECEIVED

NOV 20 1985

If well telescopes please sketch and show depths.

GROUND LEVEL

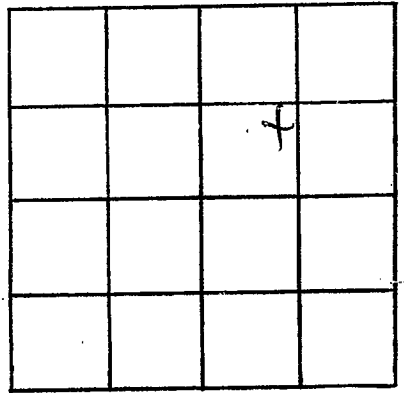

SECTION _____

Please indicate well location X.

ADDITIONAL INFORMATION

If more than one screen,
show locations of each on sketch.