

WALTHAM MISSISSIPPI BOARD OF WATER COMMISSIONERS

~~6~~ L 2001

7-28-65

WATER WELL DRILLERS LOG


Date: 7-28, 1965, Driller: S S Rouse County Waltham
GOULD (Name)

(1) Owner of Land:	Description & Color of Materials Sand, Clay, Red Clay, Shell, etc:	Thick- ness Feet	Depth Feet
<u>S Gold Turnage</u> (Name)			
<u>Jherlawn</u> (Address)	<u>Red clay</u>	<u>20</u>	
(2) Location: <u>1/4</u> , <u>15 1-13</u> , Sec. <u>T</u> <u>R</u>	<u>White clay</u>	<u>120</u>	
<u>1/4</u> miles <u>East</u> of _____ (distance) (direction) (Nearest Town)	<u>sand gravel</u>	<u>66</u>	
(3) Topography: <u>Sphered</u> (Hill) (Flat) (Level)			
(4) Purpose of Well: <u>Domestic</u> (Domestic Irrigation Municipal, Industrial, Other)			<u>206</u>

Information upon completion of well:

- (1) Diameter 4 inches.
- (2) Total Depth 206 feet.
- (3) Water Level 176 feet below top of ground.
- (4) Cased to 200, Size 4
- (5) Screen: Size 4, Length 6
- (6) Were any formations sealed against pollution?
 yes, no.

If YES depth of formation _____
 Why _____
 Drillers Remarks: _____

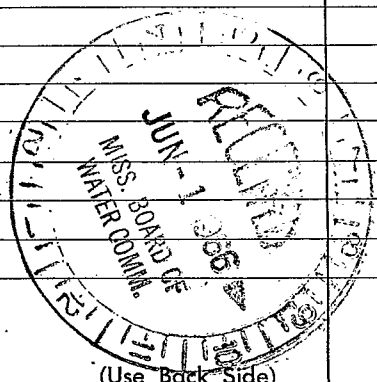

(Use Back Side)

Well No.

