

Walthall

L 2000

9-1-75

MISSISSIPPI
 BOARD OF WATER COMMISSIONERS
 416 North State Street
 Jackson, Mississippi 39201

WATER WELL DRILLERS LOG

9/1/75
date well completed

13V

Stops Well, Jr.
firm name

Walthall
county well located

LANDOWNER:
Jimmy Thoma
 (mailing address)

description of formations encountered	from	to
top soil	0	3
clay gravel	3	40
chalk	40	150
sand (fine)	150	165
sand + gravel	165	190

WELL LOCATION:
 sec. 10 T 1 N R 13 E 3
 6 miles west of Sandy Hook
 (distance) (direction) (nearest town)

WELL PURPOSE: *Home*
 (home, irrigation, municipal, industrial)

- WELL COMPLETION DATA:
- (1) diameter (inches) 4"
 - (2) total depth (feet) 190ft.
 - (3) static water level (feet) 170 below top of ground.
 - (4) casing plastic 180ft.
(material) (depth)
4" If telescope see back.
(size)
 - (5) screen 10ft. 180ft.
(length) (depth to top)
4" plastic
(size) (material)
 - (6) pump 1 (HP) 10 (yield gpm)
Elect.
(type power)
 - (7) electric log _____
(yes or no)


(organization running log)
 - (8) how well bottom plugged B.W.O.

DRILLERS REMARKS:
Jalnage Dykes

REC 11 1975
 MISS. Bd. OF WATER COMMISSIONERS

If well telescopes please sketch and show depths.

GROUND LEVEL

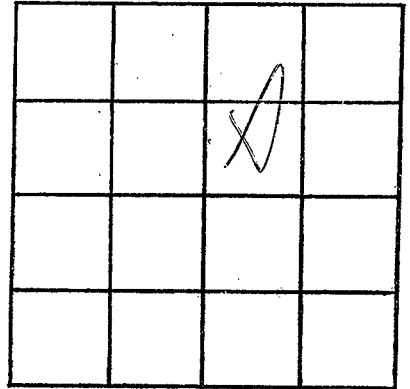

SECTION _____

Please indicate well location X.

ADDITIONAL INFORMATION

If more than one screen,
show locations of each on sketch.