

WACTHAN
L2003

MISSISSIPPI DEPARTMENT OF NATURAL RESOURCES
Bureau of Land and Water Resources
Southport Mall
P.O. Box 10631
Jackson, Mississippi 39209
WATER WELL DRILLERS LOG

8-19 1987
date well completed

J. G. Campbell & Co.
firm name

Wellhall
county well located

LANDOWNER:
Evelyn Jones
P.O. Box 145
(mailing address)

description of formations encountered	from	to
	Red clay	0
Red sand	20	110
Coarse sand & gravel	110	124

WELL LOCATION:
sec. 7 T 1 N R 13 E S W
12 miles SE of Tylertown
(distance) (direction) (nearest town)

WELL PURPOSE:
Home
(home, irrigation, municipal, industrial)

- WELL COMPLETION DATA:
- (1) diameter (inches) 4
 - (2) total depth (feet) 124
 - (3) static water level (feet) 82 below top of ground.
 - (4) casing PVC, 114 (material), (depth), 4 (size) if telescope see back.
 - (5) screen 10, 114 (length), (depth to top), 4 (size), PVC (material)
 - (6) pump 1/2 (HP), 10 (yield gpm), Elu (type power)
 - (7) electric log No (yes or no)
 - (organization running log)
 - (8) how well bottom plugged Seal block

RECEIVED


AUG 27 1987

Department of Natural Resources
Bureau of Land & Water Resources

DRILLERS REMARKS:

If well telescopes please sketch and show depths.

GROUND LEVEL

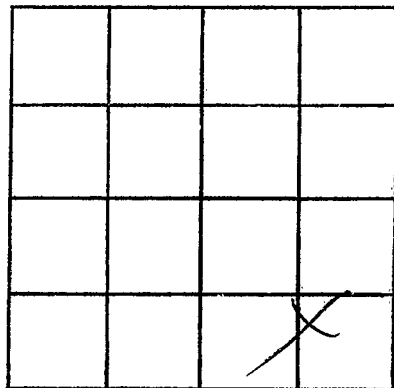

SECTION 2

Please indicate well location X.

ADDITIONAL INFORMATION

If more than one screen,
show locations of each on sketch.