

MISSISSIPPI DEPARTMENT OF NATURAL RESOURCES

Bureau of Land and Water Resources

P.O. Box 10631

Jackson, Mississippi 39209

WATER WELL DRILLERS LOG

COUNTY WHERE LOCATED
Walsh

WELL NUMBER _____ CODED _____

DATE WELL COMPLETED
8/14/89

PERMIT NUMBER 0-508

NAME OF DRILLING FIRM
Gordon Well Dr.

NAME & MAILING ADDRESS OF LANDOWNER
Gary Dungen
Slidell, LA.

WELL LOCATION: SEC 3 TOWNSHIP T1 RANGE N 13 E
S R 13 W

DISTANCE 10 Miles DIRECTION ese of NEAREST TOWN Sylertown

OTHER LANDMARK _____

WELL PURPOSE: Home, Irrigation, Municipal, Industrial, Fish Pond, etc.

PUMP DATA

PUMP TYPE (Circle One):
Submersible, Turbine, Jet, Flowing Well,
Other (Describe) _____

POWER TYPE (Circle One):
Electric, Tractor, Diesel, Gasoline, Butane,
Other (Describe) _____ H/P 1/2

Pump Capacity (GPM) .12 No. of Stages 8 Setting Depth 120 FT.

PUMP TEST

Well yielded _____ GPM with
a drawdown of _____ ft.
after _____ hours of pumping

WELL DATA

Well Depth <u>155</u>	Casing Diameter (in.) <u>4</u>	Casing Length (Ft.) <u>145</u>
Type of Casing <u>PVC</u>	Hole Depth <u>155</u>	Depth to Static Water Level <u>80</u>

TYPE OF COMPLETION: (Circle One or More):
Gravel Packed, Underreamed, Telescoped,
Natural Development, Open Hole, Other _____

Top of Lap Pipe or Reduction in Casing _____

FEET IF TELESCOPED OR MORE THAN ONE SCREEN: USE BACK PAGE

LOG DATA

TYPE OF LOG RUN (Circle One):
No Log Run, Electric, Gamma Ray, Density, Sonic, Neutron,
Other (Describe) _____

Name of Organization Running Log _____

SCREEN DATA

Diameter - Inches <u>4</u>	Length - Feet <u>10</u>	Slot Size - Inches <u>.12</u>
Screen Type <u>PVC</u>	Depth to Bottom - Feet <u>145</u>	

GEOLOGIC DATA (Office Use Only)

Surface Elev.	Geologic Unit	Unit Thickness	Depth to Top
Subs. SWL	Date	Analysis	Aquifer Test

Driller's Remarks _____

RECEIVED

DESCRIPTION OF FORMATIONS ENCOUNTERED	FROM	TO	FORMATIONS (Continued)	FROM	TO
<u>top soil</u>	<u>0</u>	<u>1</u>			
<u>red clay</u>	<u>1</u>	<u>40</u>			
<u>dry sand & gravel</u>	<u>40</u>	<u>85</u>			
<u>clay</u>	<u>85</u>	<u>135</u>			
<u>sand</u>	<u>135</u>	<u>155</u>			

AUG 25 1989

Department of Natural Resources
Bureau of Land & Water Resources

IF MORE SPACE IS NEEDED, USE BACK

If well telescopes please sketch and show depths.

GROUND LEVEL


1/4

150

8

15

North
 8/11/82
 Jordan
 0-208
 Jordan well

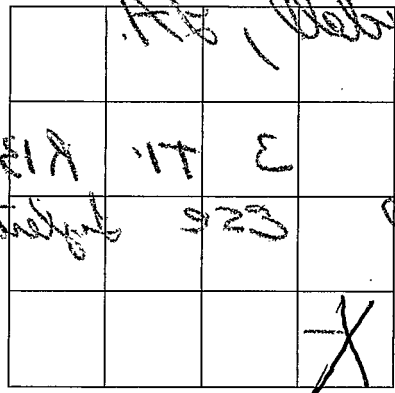

SECTION 122 1/2

Please indicate well location X

ADDITIONAL INFORMATION

10 15
 1/2
 top sand
 0 1
 1 20
 40 80
 80 120
 132 122

If more than one screen, show location of each on sketch.